

WAYNE MISSISSIPPI BOARD OF WATER COMMISSIONERS

G39

8-24-65

WATER WELL DRILLERS LOG

Date Aug 24, 1965, Driller: Porter Drilling, Inc. County Wayne  
 3P (Name)

(1) Owner of Land: Sylvester West  
 (Name)  
 Rt 1 Magnolia, Miss.  
 (Address)  
 (2) Location: SE 1/4, NE 1/4, Sec. 34 T9R8  
8 miles west of Magnolia  
 (distance) (direction) (Nearest Town)  
 (3) Topography: Hilly  
 (Hilly) (Flat) (Level)  
 (4) Purpose of Well: domestic  
 (Domestic Irrigation  
 Municipal, Industrial, Other)

Description & Color of Materials Sand, Clay, Red Clay, Shell, etc.	Thick- ness Feet	Depth Feet
<u>red clay</u>	<u>10</u>	<u>10</u>
<u>sand</u>	<u>17</u>	<u>27</u>
<u>thin rock</u>		<u>27</u>
<u>Chalk</u>	<u>37</u>	<u>64</u>
<u>pea gravel &amp; coarse sand</u>	<u>36</u>	<u>100</u>
<u>Course sand</u>	<u>11</u>	<u>111</u>
<u>stagnant white shell</u>		
<u>in sand</u>		

Information upon completion of well:


(1) Diameter 2" inches.  
 (2) Total Depth 111' feet.  
 (3) Water Level 75' feet below top of ground.  
 (4) Cased to 105', Size 2"  
 (5) Screen: Size 1/4" Length 5'  
Johnson S.S. 8 slot  
 (6) Were any formations sealed against pollution?

yes,  no.

If YES depth of formation \_\_\_\_\_

Why \_\_\_\_\_

Drillers Remarks: \_\_\_\_\_

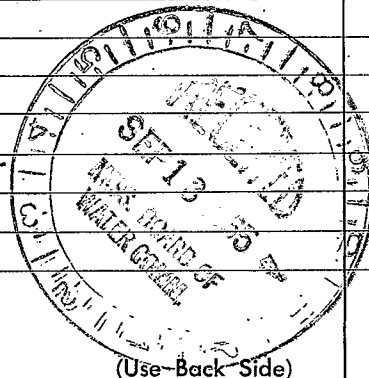

Well No. \_\_\_\_\_

