

WAYNE MISSISSIPPI BOARD OF WATER COMMISSIONERS

G 40

12-22-65 WATER WELL DRILLERS LOG

Date: Dec 22, 1965, Driller: Dexter Drilling & Pipe County Wayne  
 3P (Name)

(1) Owner of Land:	Description & Color of Materials Sand, Clay, Red Clay, Shell, etc.	Thick- ness Feet	Depth Feet
<u>Lincoln Street</u> (Name)	<u>red clay &amp; sand</u>	16	16
<u>Pl 1 Shubuta</u> (Address)	<u>white chalk &amp; sand</u>	10	26
(2) Location: <u>SW 1/4, NE 1/4, Sec. 21 T9 R8</u>	<u>white chalk</u>	49	75
<u>10</u> miles <u>west</u> of <u>Haystack</u>	<u>blue chalk</u>	47	122
(distance) (direction) (Nearest Town)	<u>rock strata few feet</u>	13	135
(3) Topography: <u>hilly</u>	<u>blue chalk</u>	11	146
(Hilly) (Flat) (Level)	<u>rock strata bottom bed</u>	11	157
(4) Purpose of Well: <u>domestic</u>	<u>blue chalk</u>	7	164
(Domestic Irrigation Municipal, Industrial, Other)	<u>sand &amp; chalk</u>	8	172
	<u>clean coarse sand</u>	12	184
	<u>blue chalk</u>	13	197
	<u>limestone rock</u>	32	229


Information upon completion of well:

- (1) Diameter 2" inches.
- (2) Total Depth 229' feet.
- (3) Water Level 98' feet below top of ground.
- (4) Cased to 205', Size 2"
- (5) Screen: Size none, Length \_\_\_\_\_
- (6) Were any formations sealed against pollution?  
 yes,  no.

If YES depth of formation \_\_\_\_\_

Why \_\_\_\_\_

Drillers Remarks: \_\_\_\_\_

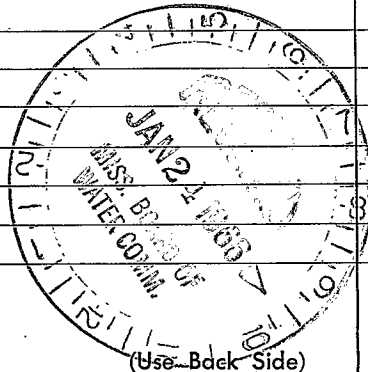

Well No.

1000