

G 42

4-2-66

WATER WELL DRILLERS LOG

Date: April 2, 1966, Driller: Porter Drilling & Supply Co. Wayne  
 3P (Name)

(1) Owner of Land	Description & Color of Materials Sand, Clay, Red Clay, Shell, etc.	Thick- ness Feet	Depth Feet
<u>Arthur Burgess</u> (Name) <u>Rt 1 Haysboro, Miss</u> (Address)	<u>sand &amp; gravel</u>	<u>40</u>	<u>40</u>
(2) Location: <u>SE 1/4, SE 1/4, Sec. 13 T9 R8</u>	<u>coarse sand</u>	<u>20</u>	<u>60</u>
<u>7</u> miles <u>NW</u> of <u>Haysboro</u>	<u>med coarse sand</u>	<u>15</u>	<u>75</u>
(distance) (direction) (Nearest Town)	<u>med fine sand</u>	<u>17</u>	<u>92</u>
(3) Topography: <u>Hilly</u>	<u>fine red sand</u>	<u>2</u>	<u>94</u>
(Hilly) (Flat) (Level)			
(4) Purpose of Well: <u>domestic</u> (Domestic Irrigation Municipal, Industrial, Other)			

Information upon completion of well:


- (1) Diameter 2' inches.
- (2) Total Depth 92' feet.
- (3) Water Level 49' feet below top of ground.
- (4) Cased to 84', Size 2"
- (5) Screen: Size 1 1/4", Length 5'  
5' 1 1/4" 6 slot Johnson S. S
- (6) Were any formations sealed against pollution?

yes,  no.

If YES depth of formation \_\_\_\_\_

Why \_\_\_\_\_

Drillers Remarks: \_\_\_\_\_

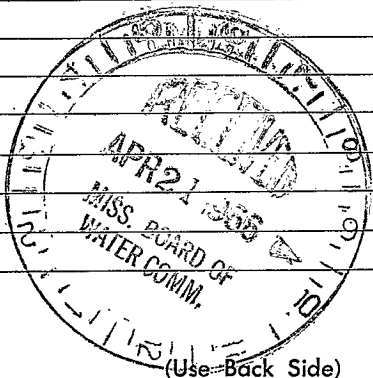

Well No. \_\_\_\_\_

