

G 43

4-12-66

WATER WELL DRILLERS LOG

Date: April 12, 1966, Driller: Porter Drilling & Supply Co., Inc., Wayne  
3P (Name)

(1) Owner of Land: <u>Allen Woodard</u> (Name)	Description & Color of Materials Sand, Clay, Red Clay, Shell, etc.	Thick- ness Feet	Depth Feet
<u>Box 1 Shubuta, Miss</u> (Address)	<u>red clay</u>	<u>5</u>	<u>5</u>
(2) Location: <u>NW 1/4, SW 1/4, Sec. 4 T. 9 R. 8</u>	<u>sand</u>	<u>15</u>	<u>20</u>
<u>11</u> miles <u>N.W.</u> of <u>Waynesboro</u> (distance) (direction) (Nearest Town)	<u>sand &amp; red chalk</u>	<u>17</u>	<u>37</u>
(3) Topography: <u>hilly</u> (Hilly) (Flat) (Level)	<u>blue chalk</u>	<u>9</u>	<u>46</u>
(4) Purpose of Well: <u>domestic</u> (Domestic Irrigation Municipal, Industrial, Other)	<u>soft rock</u>	<u>4</u>	<u>50</u>
	<u>blue chalk</u>	<u>7</u>	<u>57</u>
	<u>hard rock</u>	<u>2</u>	<u>59</u>
	<u>green chalk</u>	<u>40</u>	<u>99</u>
	<u>sand</u>	<u>1</u>	<u>100</u>
	<u>shale &amp; chalk</u>	<u>2</u>	<u>102</u>
	<u>honeysuck rock</u>	<u>25</u>	<u>127</u>
	<u>white chalk</u>	<u>4</u>	<u>131</u>


Information upon completion of well:

- (1) Diameter 2" inches.
- (2) Total Depth 131' feet.
- (3) Water Level 35' feet below top of ground.
- (4) Cased to 102', Size 2"
- (5) Screen: Size none, Length \_\_\_\_\_
- (6) Were any formations sealed against pollution?  
\_\_\_\_\_ yes,  no.

If YES depth of formation \_\_\_\_\_

Why \_\_\_\_\_

Drillers Remarks: \_\_\_\_\_

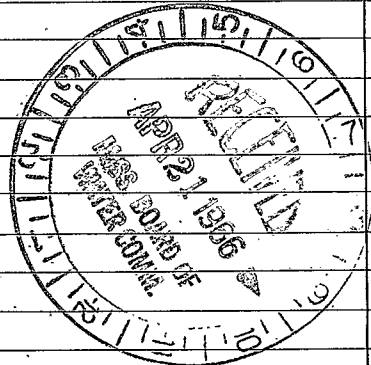

(Use Back Side)

Well No.

