

30

Wayne
G 45
2-67

MISSISSIPPI
BOARD OF WATER COMMISSIONERS
416 North State Street
Jackson, Mississippi 39201

WATER WELL DRILLERS LOG

Feb 17 1967 Porter Drilling & Pipe Wayne
date well completed firm name county well located

LANDOWNER: L J Mack
Pt 1 Waynesboro, Miss
(mailing address)


description of fomations encountered	from	to
red clay	0	10
chuck to sand	10	38
clean sand	38	47
sand to chalk	47	54
chuck	54	57

WELL LOCATION:
sec 30 T 9 N R 8 E
S W
11 miles west of Waynesboro
(distance) (direction) (nearest town)

WELL PURPOSE: home
(home, irrigation, municipal, industrial)

- WELL COMPLETION DATA:
- (1) diameter (inches) 2"
 - (2) total depth (feet) 47'
 - (3) static water level (feet) 25' below above top of ground.
 - (4) casing galv. steel, 42' (material) (depth)
2" (size) if telescope see back.
 - (5) screen 5' (length) 42' (depth to top)
1 1/4" (size) S.S. (material)
 - (6) pump 3/4 (HP) 8 (yield gpm)
elec. (type power)
 - (7) electric log no (yes or no)
(organization running log)
 - (8) how well bottom plugged 1/4" galv

DRILLERS REMARKS:

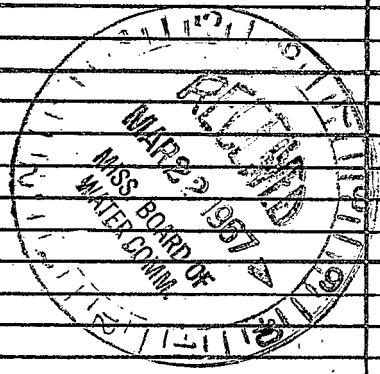

If well telescopes please sketch and show depths.

GROUND LEVEL

			X

SECTION 30

Please indicate well location X.

ADDITIONAL INFORMATION

If more than one screen, show locations of each on sketch.