

Wayne  
G 46  
3-67  
3P

MISSISSIPPI  
BOARD OF WATER COMMISSIONERS  
416 North State Street  
Jackson, Mississippi 39201

WATER WELL DRILLERS LOG

March 10 1967 Porter Drilling, Inc. Wayne  
date well completed firm name county well located

LANDOWNER:

Walter Barnett

description of formations encountered

from to

At 1 Shubuta Miss  
(mailing address)

red clay 0 10  
red sand 10 55  
ch. sh. 55 60  
fine to coarse sand 60 66  
stopped on rock

WELL LOCATION:

sec. 15 T 9 N R 8 E  
S W  
11 miles NW of Waynesboro  
(distance) (direction) (nearest town)

WELL PURPOSE: Home  
(home, irrigation, municipal, industrial)


WELL COMPLETION DATA:

- (1) diameter (inches) 2"
- (2) total depth (feet) 66
- (3) static water level (feet) 45 below above top of ground.
- (4) casing galv. steel, 63'  
(material) (depth)  
2"  
(size) if telescope see back.
- (5) screen 3, 63  
(length) (depth to top)  
1 1/4, S.S.  
(size) (material)
- (6) pump 1/2, 5  
(HP) (yield gpm)  
elec.  
(type power)
- (7) electric log no  
(yes or no)

(organization running log)


(8) how well bottom plugged  
1 1/4 plug

DRILLERS REMARKS:

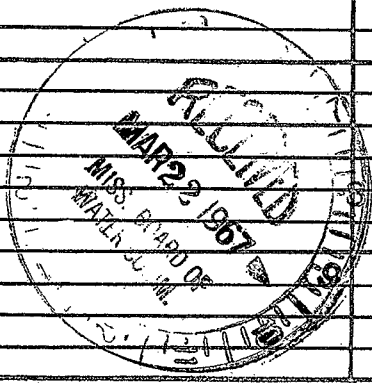

If well telescopes please sketch and show depths.

GROUND LEVEL

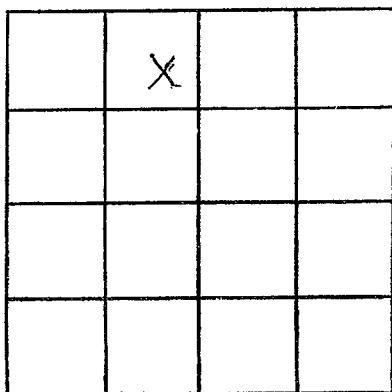

SECTION 15

Please indicate well location X.

ADDITIONAL INFORMATION

If more than one screen, show locations of each on sketch.