

38

Wayne
G 47
3-67

MISSISSIPPI
BOARD OF WATER COMMISSIONERS
416 North State Street
Jackson, Mississippi 39201

WATER WELL DRILLERS LOG

March 17 1967 Porter Drilling & Supply Wayne
date well completed firm name county well located

LANDOWNER: Clyde Armstrong

211 Wagonboro

(mailing address)

WELL LOCATION:

sec 35 T-9 N R-8 E
S 5 W 7
7 miles west of Wagonboro
(distance) (direction) (nearest town)

WELL PURPOSE:


(home, irrigation, municipal, industrial)

WELL COMPLETION DATA:

- (1) diameter (inches) 2"
- (2) total depth (feet) 132'
- (3) static water level (feet) 67 below above top of ground.
- (4) casing galv. steel, 126'
(material) (depth)
2"
(size) if telescope see back.
- (5) screen 5', 127'
(length) (depth to top)
1/4", S.S.
(size) (material)
- (6) pump 1 6
(HP) (yield gpm)
elec.
(type power)
- (7) electric log no
(yes or no)

(organization running log)
- (8) how well bottom plugged
1/4 galv. steel


Description of formations encountered	from	to
red clay	0	10
fine sand	10	84
chalk & sand	84	92
fine to med sand	92	112
coarse sand & pea gravel	112	122
coarse sand	122	132
stippled white stall in sand		

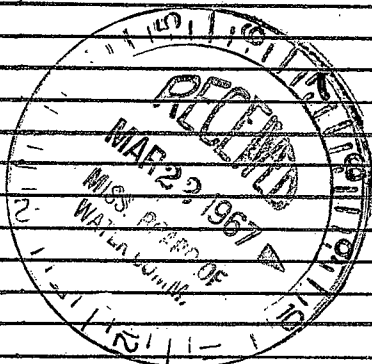

DRILLERS REMARKS:

If well telescopes please sketch and show depths.

GROUND LEVEL

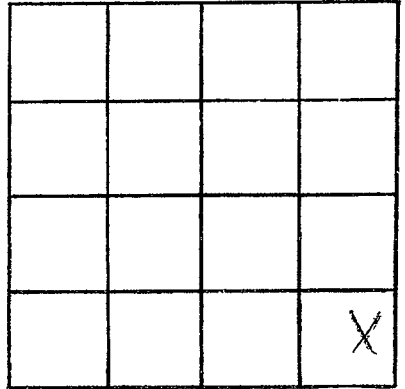

SECTION 35

Please indicate well location X.

ADDITIONAL INFORMATION

If more than one screen,
show locations of each on sketch.