

Wayne
G48
5-67
3P

MISSISSIPPI
BOARD OF WATER COMMISSIONERS
416 North State Street
Jackson, Mississippi 39201

WATER WELL DRILLERS LOG

May 9 1967 Porter Drilling Co Wayne
date well completed firm name county well located

LANDOWNER: Pete Reynolds
At 1 Shubuta, Miss

description of formations encountered	from	to
red sandy clay	0	10
sand & chalk	10	40
Coarse sand	40	50
red sand	50	56
thin rock		56
blue chalk	56	62
blue sand & some chalk	62	68
blue chalk	68	81
clean blue fine sand	81	89
blue chalk	89	96
rock stratas	96	108
blue chalk	108	144
Nicholson honeycomb		
rock	144	171

(mailing address)


WELL LOCATION:
sec. 6 T. 9 N. R. 8 E
9 miles NW of Waynesboro
(distance) (direction) (nearest town)

WELL PURPOSE: Drain
(home, irrigation, municipal, industrial)

WELL COMPLETION DATA:


- (1) diameter (inches) 2"
- (2) total depth (feet) 171'
- (3) static water level (feet) 73 below top of ground.
- (4) casing steel, 143'
(material) (depth)
2" if telescope see back.
(size)
- (5) screen none used pipe located in top of rock
(length) (depth to top)
(size) (material)
- (6) pump 1 1/2 8
(HP) (yield gpm)
elec.
(type power)
- (7) electric log no
(yes or no)
(organization running log)
- (8) how well bottom plugged
seal in rock

DRILLERS REMARKS:

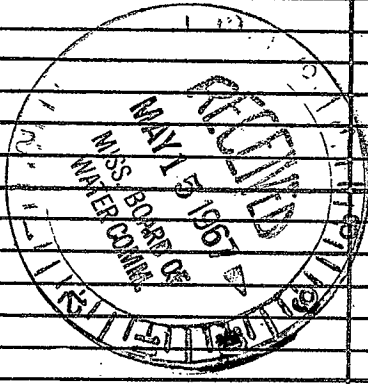

If well telescopes please sketch and show depths.

GROUND LEVEL

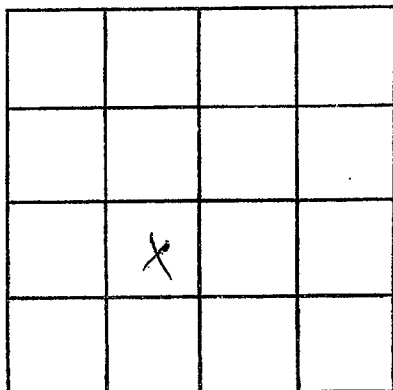

SECTION 6

Please indicate well location X.

ADDITIONAL INFORMATION

If more than one screen, show locations of each on sketch.