

Wayne
 849
 6-67
 3P

MISSISSIPPI
 BOARD OF WATER COMMISSIONERS
 416 North State Street
 Jackson, Mississippi 39201

WATER WELL DRILLERS LOG

June 12, 1967 Porter Drilling Co Wayne
 date well completed firm name county well located

LANDOWNER: Ray Dykes
211 Waynesboro Miss
 (mailing address)

description of formations encountered	from	to
red sandy clay	0	36
Chalk	36	52
sand	52	66
Chalk	66	82
fine gravel to sand	82	120
fine sand	120	132
hard coarse sand	132	140
stagnant water		
still in sand		


WELL LOCATION:
 sec. 36 T. 9 (N) R. 8 E
7 miles west of Waynesboro
 (distance) (direction) (nearest town)

WELL PURPOSE: home
 (home, irrigation, municipal, industrial)

WELL COMPLETION DATA:
 (1) diameter (inches) 2"
 (2) total depth (feet) 140'
 (3) static water level (feet) 113' below above top of ground.
 (4) casing steel, 126',
 (material) (depth)
2" if telescope see back.
 (size)
 (5) screen 5', 135'
 (length) (depth to top)
1/4", Galvalume S.S.
 (size) (material)
 (6) pump 1, 32
 (HP) (yield gpm)
rod pump
 (type power)
 (7) electric log no
 (yes or no)
 (organization running log)
 (8) how well bottom plugged
flush screen


11' 1/4" lap pipe steel
in with cylinder

DRILLERS REMARKS:

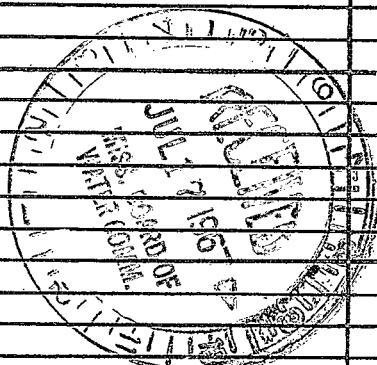

If well telescopes please sketch and show depths.

GROUND LEVEL

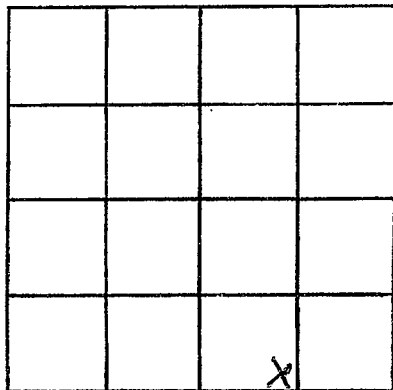

SECTION 36

Please indicate well location X.

ADDITIONAL INFORMATION

If more than one screen,
show locations of each on sketch.