

Wayne
 G50
 7-67
 3P

MISSISSIPPI
 BOARD OF WATER COMMISSIONERS
 416 North State Street
 Jackson, Mississippi 39201

WATER WELL DRILLERS LOG

July 4, 1967 Porter Drilling Co Wayne
 date well completed firm name county well located

LANDOWNER: Robert Reynolds

description of formations encountered from to

At 1 Shubuta Miss
 (mailing address)

rest clay	0	8
sand	8	23
Chalk	23	28
sand	28	84
sand with some Chalk streaks	84	90
stoped while still in some sand		

WELL LOCATION:
 sec. 3 T 9 (N) R 8 (E) W
11 miles NW of Waynesboro
 (distance) (direction) (nearest town)

WELL PURPOSE: home
 (home, irrigation, municipal, industrial)

WELL COMPLETION DATA:


- (1) diameter (inches) 2'
- (2) total depth (feet) 90
- (3) static water level (feet) 59 below above top of ground.
- (4) casing steel, 84'
 (material) (depth)
2' If telescope see back.
 (size)
- (5) screen 5', 84
 (length) (depth to top)
1/4 6661 Johnson S.S.
 (size) (material)
- (6) pump 3/4 5
 (HP) (yield gpm)
- elec
 (type power)
- (7) electric log X
 (yes or no)
- _____
 (organization running log)
- (8) how well bottom plugged flush screen

DRILLERS REMARKS:



If well telescopes please sketch and show depths.

GROUND LEVEL

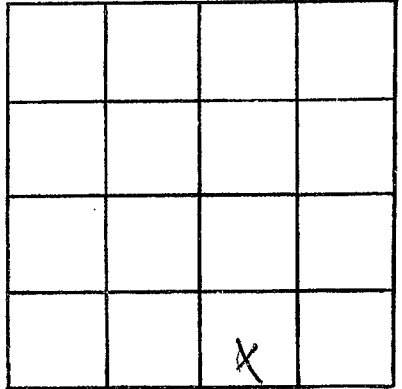

SECTION 3

Please indicate well location X.

ADDITIONAL INFORMATION

If more than one screen, show locations of each on sketch.