

**MISSISSIPPI
BOARD OF WATER COMMISSIONERS**
416 North State Street
Jackson, Mississippi 39201

WATER WELL DRILLERS LOG

Wayne
G 51
9-67
3P

Sept 20 1967 Porter Drilling Log Wayne
date well completed firm name county well located

LANDOWNER: Mrs O.M. Holland

description of formations encountered

from to

At 1 Waynesboro
(mailing address)

red clay & chert
sand

0 14
14 48

stippled chert

WELL LOCATION:

sec. 23 T-9 N 8 W
S E
6 miles NW of Waynesboro
(distance) (direction) (nearest town)


WELL PURPOSE: Home
(home, irrigation, municipal, industrial)

WELL COMPLETION DATA:

- (1) diameter (inches) 2'
- (2) total depth (feet) 47
- (3) static water level (feet) 24 below above top of ground.
- (4) casing steel, 42'
(material) (depth)
2' If telescope see back.
(size)
- (5) screen 5, 42'
(length) (depth to top)
1/4, 8 slot S.S.
(size) (material)
- (6) pump 1/2, 6
(HP) (yield gpm)
elec
(type power)
- (7) electric log _____
(yes or no)


(organization running log)
- (8) how well bottom plugged _____

DRILLERS REMARKS: _____

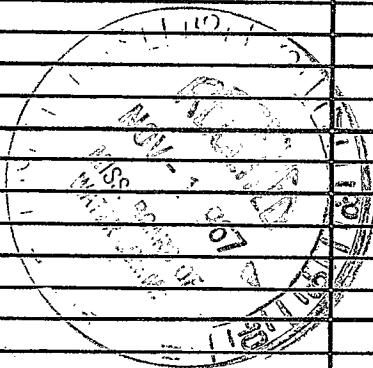

If well telescopes please sketch and show depths.

GROUND LEVEL

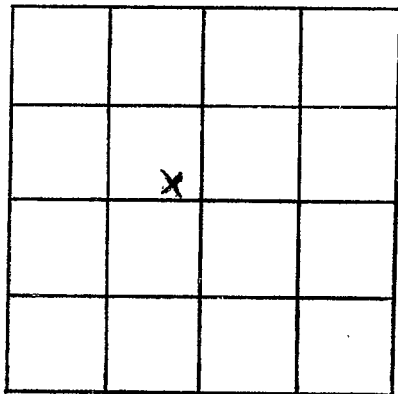

SECTION 23

Please indicate well location X.

ADDITIONAL INFORMATION

If more than one screen,
show locations of each on sketch.