

~~W~~ 653

6-62

WATER WELL DRILLERS LOG

Date: June, 1962, Driller: Peper + Rutledge County Wayne
 3P (Name)

(1) Owner of Land: David Hutchinson
 (Name)
Waynesboro
 (Address)

(2) Location: SW 1/4, NE 1/4, Sec. 6 T8R7,
6 miles W, of Waynesboro,
 (distance) (direction) (Nearest Town)

(3) Topography: Hilly
 (Hilly) (Flat) (Level)

(4) Purpose of Well: Domestic
 (Domestic Irrigation
 Municipal, Industrial, Other)

Description & Color of Materials Sand, Clay, Red Clay, Shell, etc.	Thick- ness Feet	Depth Feet
<u>top soil to red sandy</u>		
<u>clay</u>	<u>22</u>	<u>22</u>
<u>Red sand</u>	<u>10</u>	<u>32</u>
<u>yellow sand + gravel</u>	<u>52</u>	<u>84</u>
<u>White coarse sand</u>	<u>26</u>	<u>110</u>

Information upon completion of well:

(1) Diameter 2 inches.

(2) Total Depth 110 feet.

(3) Water Level 58 feet below top of ground.

(4) Cased to 105, Size 2"


(5) Screen: Size 2", Length 6'

(6) Were any formations sealed against pollution?
 _____ yes, no.

If YES depth of formation _____

Why _____

Drillers Remarks: _____

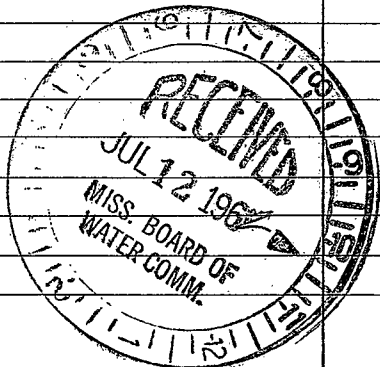

(Use Back Side)

Well No.

.....

.....

