

WAYNE
G55
4-68

MISSISSIPPI
BOARD OF WATER COMMISSIONERS
416 North State Street
Jackson, Mississippi 39201

WATER WELL DRILLERS LOG

4.25 1968 Roy V West Wayne
date well completed firm name county well located

LANDOWNER: Roscoe Brown
Rt 1 Laurel
Miss
(mailing address)


description of formations encountered	from	to
<u>sandy clay</u>	<u>0</u>	<u>15</u>
<u>sand</u>	<u>15</u>	<u>58</u>

WELL LOCATION:
sec. 3 T. 8 N. R. 9 E
15 miles E of Laurel
(distance) (direction) (nearest town)

WELL PURPOSE: home
(home; irrigation, municipal, industrial)

WELL COMPLETION DATA:

- (1) diameter (inches) 2
- (2) total depth (feet) 58
- (3) static water level (feet) 34 below top of ground.
- (4) casing Galv 52
(material) (depth)
- _____ if telescope see back.
(size)
- (5) screen 6 52
(length) (depth to top)
- 1 1/4 Brass
(size) (material)
- (6) pump 1/2 6
R.E.A (HP) (yield gpm)
(type power)
- (7) electric log No
(yes or no)
- _____ (organization running log)
- (8) how well bottom plugged Washed

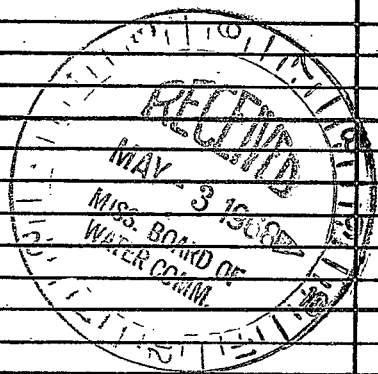

DRILLERS REMARKS:

