

Wayne
G 58
10-3-68

MISSISSIPPI
BOARD OF WATER COMMISSIONERS
416 North State Street
Jackson, Mississippi 39201

EDDED

WATER WELL DRILLERS LOG

Oct 3 1968 date well completed
B. B. Wood Drilling & Log firm name
Wayne county well located

LANDOWNER: Angie Carroll
211 Shubuta Miss
(mailing address)

description of formations encountered	from	to
red clay	0	2
red silty clay	2	32
brown yellow sand	32	42
fine sand & shells	42	50

WELL LOCATION:
sec. 15 T. 9 N R. 2 E
8 miles NW of Shubuta
(distance) (direction) (nearest town)

WELL PURPOSE: domestic
(home, irrigation, municipal, industrial)

WELL COMPLETION DATA:

(1) diameter (inches) 2 1/2

(2) total depth (feet) 48

(3) static water level (feet) 31 below above top of ground.

(4) casing steel, 42,
(material) (depth)
2" if telescope see back.
(size)

(5) screen 6', 42
(length) (depth to top)
1/2", 10' from base of casing
(size) (material)

(6) pump 1/2, 2
(HP) (yield gpm)
elec
(type power)

(7) electric log no
(yes or no)

(organization running log)

EDDED

(8) how well bottom plugged with cement


DRILLERS REMARKS:

OCT 14 1968

MISS. RD. OF
WATER COMM.

If well telescopes please sketch and show depths.

GROUND LEVEL

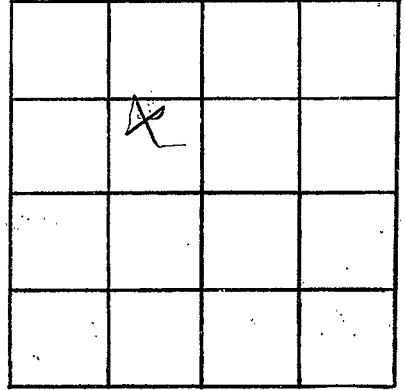

SECTION 15

Please indicate well location X.

ADDITIONAL INFORMATION

If more than one screen, show locations of each on sketch.