

WAYNE
659
10-8-68

MISSISSIPPI
BOARD OF WATER COMMISSIONERS
416 North State Street
Jackson, Mississippi 39201

CODED

WATER WELL DRILLERS LOG

10.8 1968 Roy V West Wayne
date well completed firm name county well located

LANDOWNER: M.D. Odum
Rt 1
Waynesboro Miss
(mailing address)

description of formations encountered	from	to
clay	0	8
sand	8	20
clay	20	80
sand	80	104


WELL LOCATION:
sec 34 T 9 N R 8 E
1 1/2 miles East of Laurel Miss
(distance) (direction) (nearest town)

WELL PURPOSE: Home
(home, irrigation, municipal, industrial)

WELL COMPLETION DATA:

(1) diameter (inches) 2
(2) total depth (feet) 104
(3) static water level (feet) 80 below top of ground.
(4) casing Galv 99 (material) (depth)
(size) if telescope see back.
(5) screen 5 99 (length) (depth to top)
2 in. St Steel (size) (material)
(6) pump 1 5 (HP) (yield gpm)
REA (type power)
(7) electric log no (yes or no)
(organization running log)
(8) how well bottom plugged washed


CODED

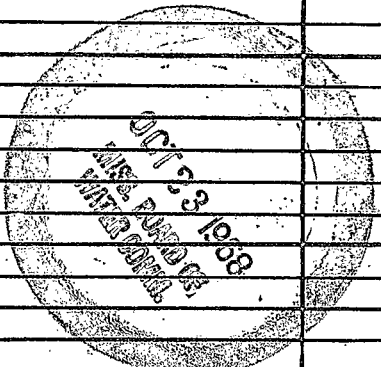

DRILLERS REMARKS:

If well telescopes please sketch and show depths.

GROUND LEVEL

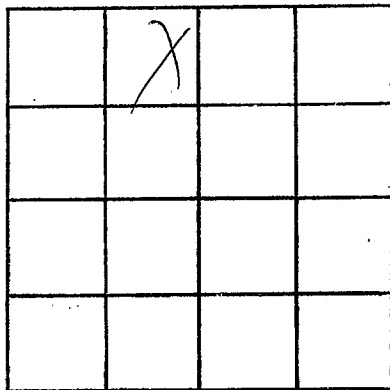

SECTION 34

Please indicate well location X.

ADDITIONAL INFORMATION

If more than one screen, show locations of each on sketch.