

WAYNE  
GGO  
1-7-69

MISSISSIPPI  
BOARD OF WATER COMMISSIONERS  
416 North State Street  
Jackson, Mississippi 39201

CODED

WATER WELL DRILLERS LOG

17 1969 Ray West Wayne  
date well completed firm name county well located

LANDOWNER: R. R. Benette  
Rt 1  
Shubuta Miss  
(mailing address)

description of formations encountered	from	to
<u>Clay</u>	<u>0</u>	<u>5</u>
<u>sandy clay</u>	<u>5</u>	<u>20</u>
<u>Sand</u>	<u>20</u>	<u>69</u>

WELL LOCATION:  
sec. 18 T 9 N R 8 E  
15 miles NE of Troul  
(distance) (direction) (nearest town)

WELL PURPOSE: home  
(home, irrigation, municipal, industrial)

- WELL COMPLETION DATA:
- (1) diameter (inches) 2 in
  - (2) total depth (feet) 69
  - (3) static water level (feet) 45 <sup>below</sup> / <sub>above</sub> top of ground.
  - (4) casing galv 64  
(material) (depth)  
(size) if telescope see back.
  - (5) screen 5 64  
(length) (depth to top)  
1/4 St Steel  
(size) (material)
  - (6) pump 1/2 5  
(HP) (yield gpm)  
Rea  
(type power)
  - (7) electric log NO  
(yes or no)  
(organization running log)
  - (8) how well bottom plugged wash


CODED

JAN 22 1969  
MISSISSIPPI  
STATE BOARD OF WATER COMMISSIONERS

DRILLERS REMARKS:

If well telescopes please sketch and show depths.

GROUND LEVEL

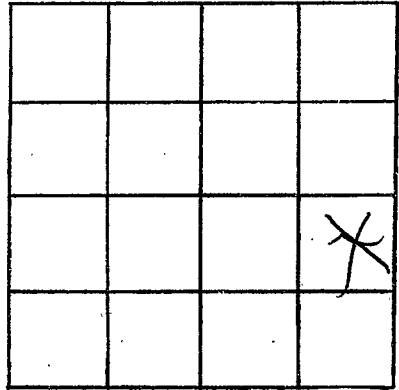

SECTION 18

Please indicate well location X.

ADDITIONAL INFORMATION

If more than one screen,  
show locations of each on sketch.