

MISSISSIPPI  
BOARD OF WATER COMMISSIONERS  
416 North State Street  
Jackson, Mississippi 39201

CODED  
CODED

WATER WELL DRILLERS LOG

Wayne  
G 61  
2-1-69  
Feb 1 1969  
date well completed  
Boyer Drilling & Log  
firm name  
Wayne  
county well located

LANDOWNER: James Butler

description of formations encountered

from

to

At 1 Shubuta Miss  
(mailing address)

red clay  
sand  
shale white shell  
red sand

0 2  
8 97

WELL LOCATION:

sec 16 T 7 N R 8 E  
10 miles NW of Waynesboro  
(distance) (direction) (nearest town)

WELL PURPOSE: home  
(home, irrigation, municipal, industrial)

WELL COMPLETION DATA:

- (1) diameter (inches) 2"
- (2) total depth (feet) 97'
- (3) static water level (feet) 60' below above top of ground.
- (4) casing steel 90' (material) (depth)  
2" If telescope see back. (size)
- (5) screen 6' 91' (length) (depth to top)  
1/2" 80 ga S.S. (size) (material)
- (6) pump 1/2 (HP) 3 1/2 (yield gpm)  
elec rod (type power)
- (7) electric log no (yes or no)

6 1/2" 80 ga screen  
with 1 1/2" log tied  
in with cylinder

(organization running log)


(8) how well bottom plugged  
flush point

DRILLERS REMARKS:

FEB - 7 1969  
MISS. Bd. OF  
WATER COMMISSIONERS

If well telescopes please sketch and show depths.

GROUND LEVEL

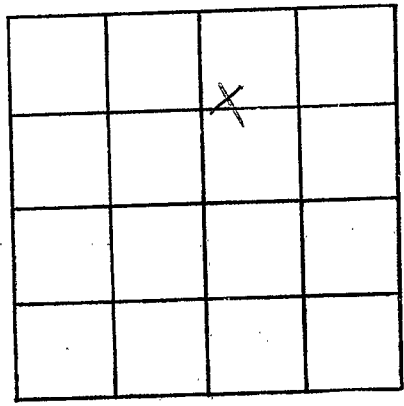

SECTION 16

Please indicate well location X.

ADDITIONAL INFORMATION

Lined area for additional information.

If more than one screen, show locations of each on sketch.