

WAYNE
G 62
3-3-69

MISSISSIPPI
BOARD OF WATER COMMISSIONERS
416 North State Street
Jackson, Mississippi 39201

CODED

WATER WELL DRILLERS LOG

Mar 3 1969 Roy West Wayne
date well completed firm name county well located

LANDOWNER: Mrs. Eula McKee
RT 1
Waynesboro Miss
(mailing address)

description of formations encountered
Clay
Sand
from 0 to 5
5 70

WELL LOCATION:
sec. 23 T 9 N R 8 E
2.0 miles E of Laurel
(distance) (direction) (nearest town)

WELL PURPOSE: home
(home, irrigation, municipal, industrial)

- WELL COMPLETION DATA:
- (1) diameter (inches) 2
 - (2) total depth (feet) 70
 - (3) static water level (feet) 28 below top of ground.
 - (4) casing galv 65 (material) (depth)
 - ~~10~~ if telescope see back. (size)
 - (5) screen 5ft 65 (length) (depth to top)
 - 1 1/2 St steel (size) (material)
 - (6) pump 3/4 8 (HP) (yield gpm)
 - Rea (type power)
 - (7) electric log 70 (yes or no)
 - (organization running log)
 - (8) how well bottom plugged Washed

CODED


APR 2 1969

MISS. BD. OF WATER COM.

DRILLERS REMARKS:

If well telescopes please sketch and show depths.

GROUND LEVEL

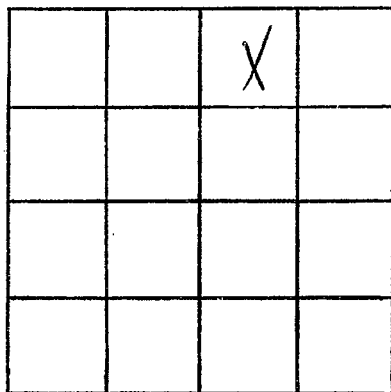

SECTION 23

Please indicate well location X.

ADDITIONAL INFORMATION

If more than one screen, show locations of each on sketch.