

**MISSISSIPPI
BOARD OF WATER COMMISSIONERS**
416 North State Street
Jackson, Mississippi 39201

CODED

WATER WELL DRILLERS LOG

Wayne
G63
5-16-69

May 16 1969 Porter Drilling Co Wayne
date well completed firm name county well located

LANDOWNER: Stinson Clark
802 South St
Stamwacker Miss
(mailing address)

description of formations encountered	from	to
<u>rest clay</u>	<u>0</u>	<u>10</u>
<u>blue sand</u>	<u>10</u>	<u>19</u>
<u>chalk & sand</u>	<u>19</u>	<u>32</u>
<u>sand</u>	<u>32</u>	<u>49</u>
<u>stagnant on chalk</u>		
<u>42' ty deep pipe</u>		

WELL LOCATION:
sec. 34 T 7 N R 8 E
8 miles SW of Stamwacker
(distance) (direction) (nearest town)

WELL PURPOSE: camp
(home, irrigation, municipal, industrial)

WELL COMPLETION DATA:

(1) diameter (inches) 2"

(2) total depth (feet) 49'

(3) static water level (feet) 36 below
top of ground.

(4) casing steel, 44'
(material) (depth)
2"
(size) If telescope see back.

(5) screen 5', 44'
(length) (depth to top)
1 1/2", galv. S.S.
(size) (material)

(6) pump 1/2, 5
(HP) (yield gpm)
elec
(type power)

(7) electric log No
(yes or no)

(organization running log)

(8) how well bottom plugged plumb cement


DRILLERS REMARKS:

JUL 3 - 1969

MISS. Bd. OF
WATER COMM.

If well telescopes please sketch and show depths.

GROUND LEVEL

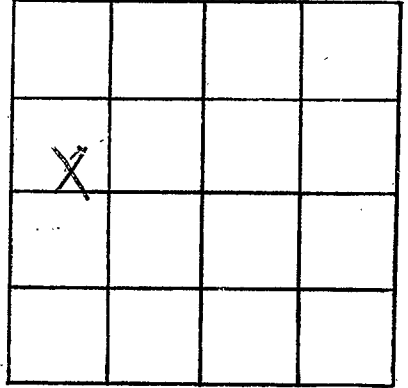

SECTION 34

Please indicate well location X.

ADDITIONAL INFORMATION

If more than one screen,
show locations of each on sketch.