

Wayne
G 64
5-9-69

MISSISSIPPI
BOARD OF WATER COMMISSIONERS
416 North State Street
Jackson, Mississippi 39201

CODED

WATER WELL DRILLERS LOG

May 9 1969 date well completed
Rosta Drilling Log firm name
Wayne county well located


| LANDOWNER: <u>W. J. Jolley</u> | description of formations encountered | from | to |
|---|---------------------------------------|------------|------------|
| <u>1111 Shubuta Miss</u> (mailing address) | <u>red clay</u> | <u>0</u> | <u>10</u> |
| WELL LOCATION: sec <u>7</u> T <u>2</u> N R <u>8</u> E <u>8</u> miles <u>NW</u> of <u>Shubuta</u> (distance) (direction) (nearest town) | <u>granite & quartz</u> | <u>10</u> | <u>50</u> |
| WELL PURPOSE: (home, irrigation, municipal, industrial) | <u>dark sandstone</u> | <u>50</u> | <u>63</u> |
| WELL COMPLETION DATA: | <u>black</u> | <u>63</u> | <u>74</u> |
| (1) diameter (inches) <u>2"</u> | <u>red sand</u> | <u>74</u> | <u>120</u> |
| (2) total depth (feet) <u>153</u> | <u>white sand</u> | <u>120</u> | <u>132</u> |
| (3) static water level (feet) <u>74</u> below top of ground. | <u>white sand</u> | <u>132</u> | <u>153</u> |
| (4) casing <u>1 1/2"</u> (material) <u>147'</u> (depth) If telescope see back. (size) | <u>white sand</u> | | |
| (5) screen <u>5'</u> (length) <u>134</u> (depth to top) <u>1 1/2"</u> (size) <u>galv S.S.</u> (material) | <u>white sand</u> | | |
| (6) pump <u>1/2</u> (HP) <u>32</u> (yield gpm) <u>elec.</u> (type power) | <u>white sand</u> | | |
| (7) electric log <u>no</u> (yes or no) (organization running log) | <u>white sand</u> | | |
| (8) how well bottom plugged <u>not plugged</u> | <u>white sand</u> | | |
| DRILLERS REMARKS: | | | |

JUN 2 1969

MISS. BD. OF
WATER COMMISSIONERS

If well telescopes please sketch and show depths.

GROUND LEVEL

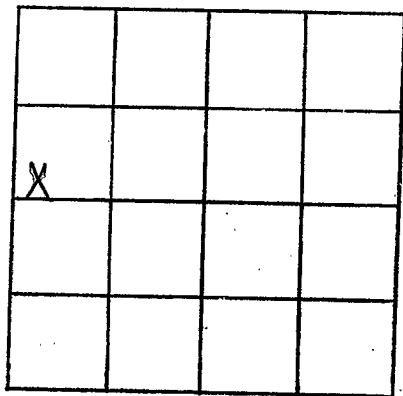

SECTION 7

Please indicate well location X.

ADDITIONAL INFORMATION

If more than one screen,
show locations of each on sketch.