

WAYNE  
 666  
 6-27-69

MISSISSIPPI  
 BOARD OF WATER COMMISSIONERS  
 416 North State Street  
 Jackson, Mississippi 39201

CODED

CODED


WATER WELL DRILLERS LOG

June 27, 1969 Booth Drilling Co. Wayne  
 date well completed firm name county well located

LANDOWNER: <u>Booth Drilling Co.</u>	description of formations encountered	from	to
<u>Booth Drilling Co.</u>	<u>sand</u>	<u>0</u>	<u>12</u>
(mailing address)	<u>chert</u>	<u>12</u>	<u>25</u>
	<u>blue shale</u>	<u>25</u>	<u>103</u>
	<u>blue shale</u>	<u>103</u>	<u>107</u>
	<u>blue shale</u>	<u>107</u>	<u>154</u>
WELL LOCATION: sec. <u>4</u> T. <u>9</u> N. R. <u>2</u> E. <u>8</u> miles <u>NW</u> of <u>Waynesboro</u> (distance) (direction) (nearest town)			
WELL PURPOSE: <u>Chum</u> (home, irrigation, municipal, industrial)			
WELL COMPLETION DATA:			
(1) diameter (inches) <u>2"</u>	<u>126' 1 1/2" string pipe</u>		
(2) total depth (feet) <u>182</u>			
(3) static water level (feet) <u>103</u> (below/above top of ground)			
(4) casing <u>steel</u> , <u>155'</u> (material) (depth)			
<u>2"</u> (size) if telescope see back.			
(5) screen <u>none present</u> (length) (depth to top)			
(size) (material)			
(6) pump <u>2</u> (HP) <u>7 1/2</u> (yield gpm)			
<u>elec.</u> (type power)			
(7) electric log <u>no</u> (yes or no)			
(organization running log)			
(8) how well bottom plugged			
DRILLERS REMARKS:	AUG 15 1969 MISSISSIPPI BOARD OF WATER COMMISSIONERS JACKSON, MISSISSIPPI		

If well telescopes please sketch and show depths.

GROUND LEVEL

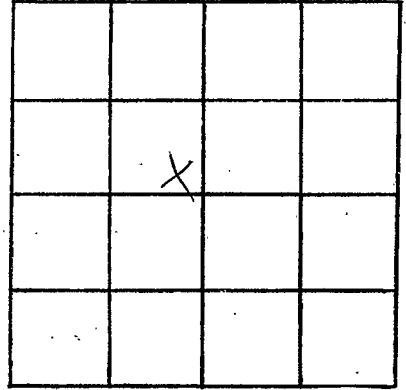

SECTION 4

Please indicate well location X.

ADDITIONAL INFORMATION

If more than one screen,  
show locations of each on sketch.