

Wayne  
G 67  
10-7-69

MISSISSIPPI  
BOARD OF WATER COMMISSIONERS  
416 North State Street  
Jackson, Mississippi 39201

CODED

WATER WELL DRILLERS LOG

10-7 1969 Roy Westwaterwell Wayne  
date well completed firm name county well located


<p>LANDOWNER: <u>H. E. Reynolds</u> <u>Shubuta Rt 1</u> (mailing address)</p>	<table border="1"> <thead> <tr> <th data-bbox="583 418 993 500">description of formations encountered</th> <th data-bbox="993 418 1077 500">from</th> <th data-bbox="1077 418 1161 500">to</th> </tr> </thead> <tbody> <tr> <td data-bbox="583 500 993 546"><u>Clay</u></td> <td data-bbox="993 500 1077 546"><u>0</u></td> <td data-bbox="1077 500 1161 546"><u>15</u></td> </tr> <tr> <td data-bbox="583 546 993 591"><u>Sandy clay</u></td> <td data-bbox="993 546 1077 591"><u>15</u></td> <td data-bbox="1077 546 1161 591"><u>35</u></td> </tr> <tr> <td data-bbox="583 591 993 627"><u>Sand</u></td> <td data-bbox="993 591 1077 627"><u>35</u></td> <td data-bbox="1077 591 1161 627"><u>68</u></td> </tr> </tbody> </table>	description of formations encountered	from	to	<u>Clay</u>	<u>0</u>	<u>15</u>	<u>Sandy clay</u>	<u>15</u>	<u>35</u>	<u>Sand</u>	<u>35</u>	<u>68</u>
description of formations encountered	from	to											
<u>Clay</u>	<u>0</u>	<u>15</u>											
<u>Sandy clay</u>	<u>15</u>	<u>35</u>											
<u>Sand</u>	<u>35</u>	<u>68</u>											
<p>WELL LOCATION: sec. <u>18</u> T <u>9</u> N R <u>8</u> E S W <u>15</u> miles <u>West</u> of <u>Waynesboro</u> (distance) (direction) (nearest town)</p>													
<p>WELL PURPOSE: <u>home</u> (home, irrigation, municipal, industrial)</p>													
<p>WELL COMPLETION DATA:</p> <p>(1) diameter (inches) <u>2 in</u></p> <p>(2) total depth (feet) <u>68 ft</u></p> <p>(3) static water level (feet) <u>40</u> <sup>below</sup> <del>above</del> top of ground.</p> <p>(4) casing <u>Galv</u> <u>63</u> (material) (depth) (size) If telescope see back.</p> <p>(5) screen <u>5 ft</u> <u>63</u> (length) (depth to top) <u>1/4</u> <u>St Steel</u> (size) (material)</p> <p>(6) pump <u>1/2</u> <u>4</u> (HP) (yield gpm) <u>R&amp;A</u> (type power)</p> <p>(7) electric log <u>no</u> (yes or no)</p> <p>(organization running log)</p> <p>(8) how well bottom plugged <u>Washed</u></p>													
<p>DRILLERS REMARKS:</p>													

OCT 15 1969

MISS. BD. OF  
WATER COMM.

If well telescopes please sketch and show depths.

GROUND LEVEL

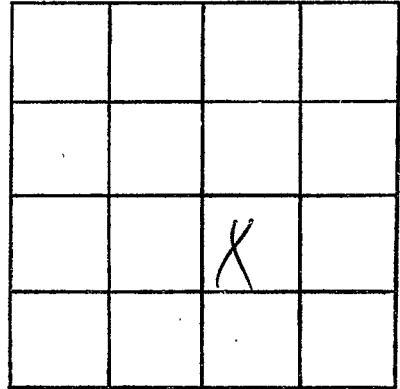

SECTION 18

Please indicate well location X.

ADDITIONAL INFORMATION

If more than one screen,  
show locations of each on sketch.