

WAYNE

G 68

10-23-69

MISSISSIPPI BOARD OF WATER COMMISSIONERS 416 North State Street Jackson, Mississippi 39201

CODED

WATER WELL DRILLERS LOG

Oct 23 1969

1969

Porter Drilling Inc

firm name

Wayne

county well located

LANDOWNER: James Cooley

description of formations encountered

from

to

211 Shubuta

(mailing address)

Clay & sand

0

15

chalk

15

37

sand

37

46

sand & chalk

46

49

stop on chalk

WELL LOCATION:

sec 12 T 9 N R 8 E S 7 miles NW of Haywood

WELL PURPOSE: home (home, irrigation, municipal, industrial)

WELL COMPLETION DATA:

- (1) diameter (inches) 2"
(2) total depth (feet) 46
(3) static water level (feet) 33 below top of ground
(4) casing steel 42' (material), (depth) 2" (size) If telescope see back.
(5) screen 4' (length), 42' (depth to top) 2" (size) 60 mesh bronze rock
(6) pump 1/2 HP (HP), 3 1/2 (yield gpm) elec (type power)
(7) electric log no (yes or no)

(organization running log)

(8) how well bottom plugged


NOV 14 1969

DRILLERS REMARKS:

MISS. BD. OF WATER COM.

If well telescopes please
sketch and show depths.

GROUND LEVEL

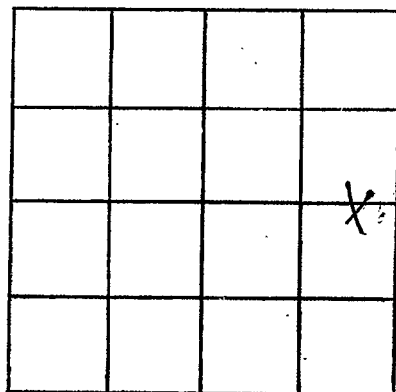

SECTION 12

Please indicate well location X.

ADDITIONAL INFORMATION

If more than one screen,
show locations of each on sketch.