

Wayne
G 69
10-29-69

MISSISSIPPI
BOARD OF WATER COMMISSIONERS
416 North State Street
Jackson, Mississippi 39201

CODED

WATER WELL DRILLERS LOG


Oct 29 1969 Porter Drilling & Log Wayne
date well completed firm name county well located

| LANDOWNER: <u>Danny Finley</u> | description of formations encountered | from | to | |
|---|---------------------------------------|------|-----|--|
| <u>Box 1 Shubuta, Miss</u> (mailing address) | <u>red clay</u> | 0 | 20 | |
| WELL LOCATION: sec <u>1</u> T <u>9</u> N R <u>8</u> E <u>8</u> miles <u>N.W.</u> of <u>Shubuta</u> (distance) (direction) (nearest town) | <u>sand & pebbles gravel</u> | 20 | 41 | |
| | <u>chalk</u> | 41 | 45 | |
| | <u>sand</u> | 45 | 105 | |
| | <u>thin silt</u> | | 105 | |
| | <u>blue chalk</u> | 105 | 156 | |
| | <u>or yellowish limestone</u> | | 156 | |
| | <u>or silt</u> | 156 | 176 | |
| WELL PURPOSE: <u>Home</u> (home, irrigation, municipal, industrial) | | | | |
| WELL COMPLETION DATA: | | | | |
| (1) diameter (inches) <u>2"</u> | <u>Cyl. set at 151'</u> | | | |
| (2) total depth (feet) <u>176</u> | | | | |
| (3) static water level (feet) <u>140</u> (below/above top of ground) | | | | |
| (4) casing <u>steel</u> <u>156'</u> (material) (depth) | | | | |
| <u>2"</u> if telescope see back. (size) | | | | |
| (5) screen <u>no</u> <u>med</u> (length) (depth to top) | | | | |
| (size) (material) | | | | |
| (6) pump <u>3/4</u> <u>3 1/2</u> (HP) (yield gpm) | | | | |
| <u>elec</u> (type power) | | | | |
| (7) electric log <u>no</u> (yes or no) | | | | |
| (organization running log) | | | | |
| (8) how well bottom plugged <u>yes</u> | | | | |
| DRILLERS REMARKS: | | | | |

MISSISSIPPI
BOARD OF WATER COMMISSIONERS
JACKSON, MISSISSIPPI

If well telescopes please sketch and show depths.

GROUND LEVEL

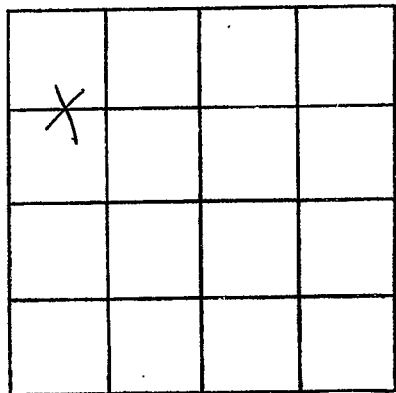

SECTION 1

Please indicate well location X.

ADDITIONAL INFORMATION

If more than one screen,
show locations of each on sketch.