

Wayne

G 72

1-27-70

MISSISSIPPI
 BOARD OF WATER COMMISSIONERS
 416 North State Street
 Jackson, Mississippi 39201

CODED

WATER WELL DRILLERS LOG

1.27

1970

Roy V West Water Wells Wayne

date well completed

firm name

county well located

LANDOWNER:

Aubrey Holland

description of formations encountered

from

to

Rt 6

0-15 sandy clay

0 15

Waynesboro

(mailing address)

sand

15 30

sandy clay

30 70

pond

70 110

WELL LOCATION:

sec 23 T 9 N R 8 E

2

miles

North of Beat Iron

(distance)

(direction)

(nearest town)

WELL PURPOSE:

home

(home, irrigation, municipal, industrial)

WELL COMPLETION DATA:

(1) diameter (inches)

2

(2) total depth (feet)

110

(3) static water level (feet)

80

below top of ground

(4) casing

galv (material)

105 (depth)

(size)

if telescope see back.

(5) screen

5 ft (length)

105 (depth to top)

(size)

(material)

1 1/4 St Steel

(6) pump

1/2 (HP)

4 (yield gpm)

(type power)

REA

(7) electric log

no

(yes or no)

(organization running log)

(8) how well bottom plugged


washed

DRILLERS REMARKS:

FEB 27 1970 MISS. Bd. OF WATER

If well telescopes please sketch and show depths.

GROUND LEVEL

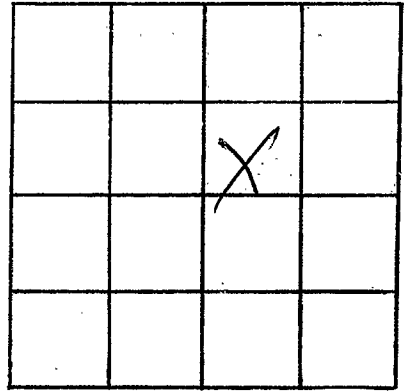

SECTION 23

Please indicate well location X.

ADDITIONAL INFORMATION

If more than one screen,
show locations of each on sketch.