

Wayne
G 73
3-4-70

C. P. CLARK
WATER WELL DRILLING
ROUTE 2
NORFOLK, MISS. 39440

MISSISSIPPI
BOARD OF WATER COMMISSIONERS
416 North State Street
Jackson, Mississippi 39201

WATER WELL DRILLERS LOG

INDEXED

date well completed 3/4 1970 firm name C. P. Clark county well located Wayne

LANDOWNER: Walter Edison
Pt #1
Shulutta, Miss.
(mailing address)

description of formations encountered	depth	
	from	to
<u>Sandy Clay</u>	<u>0</u>	<u>20</u>
<u>Medium Sand</u>	<u>20</u>	<u>33</u>
<u>Coarse Sand</u>	<u>33</u>	<u>73</u>

WELL LOCATION:
sec. 18 T. 9 N. R. 4 E.
11 miles NE of Waynesboro
(distance) (direction) (nearest town)

WELL PURPOSE: Home
(home, irrigation, municipal, industrial)

WELL COMPLETION DATA:

- (1) diameter (inches) 2
- (2) total depth (feet) 73
- (3) static water level (feet) 53 below above top of ground.
- (4) casing Galvanon
(material) (depth)
- (size) if telescope see back.
- (5) screen 5 ft, 68
(length) (depth to top)
1/4 S.S. Solid
(size) (material)
- (6) pump 3/4 8 1/2
(HP) (yield.gpm)
110 V SP
(type.power)
- (7) electric log no
(yes.or.no)
- (organization.running.log) BWU
- (8) how.well.bottom.plugged BWU

INDEXED


MAR 9 - 1970

MISS. BD. OF
WATER COMM.

DRILLERS REMARKS:

If well telescopes please sketch and show depths.

GROUND LEVEL

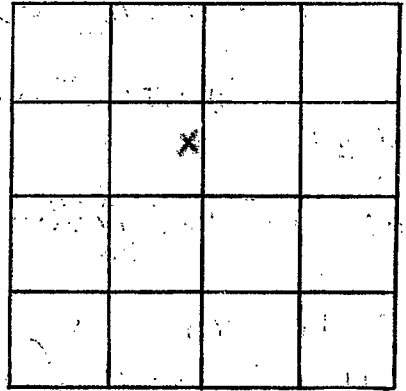

SECTION 18

Please indicate well location X.

ADDITIONAL INFORMATION

If more than one screen,
show locations of each on sketch.