

Wayne Co  
G 74  
3-27-70

MISSISSIPPI  
BOARD OF WATER COMMISSIONERS  
416 North State Street  
Jackson, Mississippi 39201

WATER WELL DRILLERS LOG

March 27 1970 Hollands Water Well Co. same  
date well completed firm name county well located


LANDOWNER: <u>Edna McKee</u>	description of formations encountered	from	to
<u>Route 1</u>	<u>top soil</u>	<u>0</u>	<u>2</u>
<u>Waynesboro, Miss.</u> (mailing address)	<u>red sandy clay</u>	<u>2</u>	<u>14</u>
WELL LOCATION: sec. <u>4</u> T. <u>9</u> N. R. <u>2</u> E S W	<u>fine white sand</u>	<u>14</u>	<u>26</u>
<u>14</u> miles <u>N-W</u> of <u>Waynesboro</u> (distance) (direction) (nearest town)	<u>coarse white sand</u>	<u>26</u>	<u>38</u>
WELL PURPOSE: <u>home</u> (home, irrigation, municipal, industrial)	<u>medium red sand</u>	<u>38</u>	<u>46</u>
WELL COMPLETION DATA:	<u>sand rock &amp; Chalk</u>	<u>46</u>	<u>60</u>
(1) diameter (inches) <u>4" x 2"</u>	<u>blue clay</u>	<u>60</u>	<u>105</u>
(2) total depth (feet) <u>191</u>	<u>white lim. rock</u>	<u>105</u>	<u>108</u>
(3) static water level (feet) <u>114</u> <sup>below</sup> above top of ground.	<u>soft white lime rock</u>	<u>108</u>	<u>111</u>
(4) casing <u>galv.</u> <u>161'</u> (material) (depth)	<u>hard white lime rock</u>	<u>111</u>	<u>112</u>
<u>2"</u> If telescope see back. (size)	<u>blue clay</u>	<u>112</u>	<u>161</u>
(5) screen <u>NONE</u> (length) (depth to top)	<u>lime rock</u>	<u>161</u>	<u>176</u>
(size) (material)	<u>white chalk</u>	<u>176</u>	<u>178</u>
(6) pump <u>1</u> <u>8</u> (HP) (yield gpm)	<u>lime rock</u>	<u>178</u>	<u>183</u>
<u>Elect.</u> (type power)	<u>white chalk</u>	<u>183</u>	<u>186</u>
(7) electric log <u>NO</u> (yes or no)	<u>lime rock</u>	<u>186</u>	<u>191</u>
(organization running log)			
(8) how well bottom plugged			
DRILLERS REMARKS:			

MAR 31 1971

MISS. BD. OF  
WATER COMMISSIONERS

If well telescopes please sketch and show depths.

GROUND LEVEL

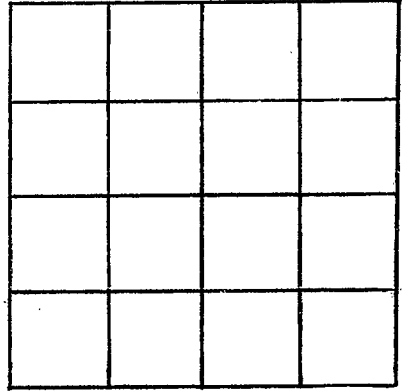

SECTION \_\_\_\_\_

Please indicate well location X.

ADDITIONAL INFORMATION

If more than one screen, show locations of each on sketch.