

MISSISSIPPI BOARD OF WATER COMMISSIONERS

Wayne  
G-76

Cased  
7/2/69 gcr

WATER WELL DRILLERS LOG

2-5-63

Date: 2/5, 1963, Driller: C.P. Clark

C.P. Clark

Wayne

CODED

(1) Owner of Land: Leone West  
(Name)  
Rt #1 Waynesboro Miss  
(Address)  
31 9N 8W  
(2) Location: 20 miles East of Lawel  
(distance) (direction) (Nearest Town)  
(3) Topography:  (Hilly)  (Flat)  (Level)  
(4) Purpose of Well: Domestic  
(Domestic Irrigation  
Municipal, Industrial, Other)


Description & Color of Materials Sand, Clay, Red Clay, Shell, etc.	Thick- ness Feet	Depth Feet
<u>0-50 Yellow Clay</u>	<u>50</u>	
<u>50-120 fine Sand</u>	<u>70</u>	
<u>120-146 coarse Sand</u>	<u>26</u>	

Information upon completion of well:

- (1) Diameter 2 inches.
- (2) Total Depth 146 feet.
- (3) Water Level 62 feet below top of ground.
- (4) Cased to 141, Size 2 in.
- (5) Screen: Size 1/4, Length 5'.
- (6) Were any formations sealed against pollution?  
\_\_\_\_\_ yes,  no.

If YES depth of formation \_\_\_\_\_  
Why \_\_\_\_\_

Drillers Remarks: \_\_\_\_\_  
\_\_\_\_\_  
\_\_\_\_\_

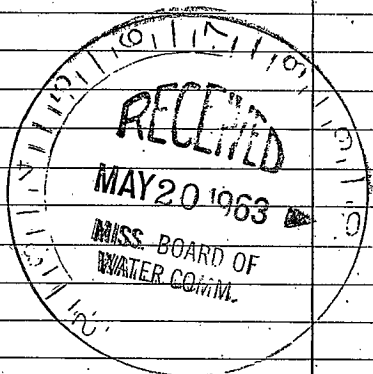

(Use Back Side)

Retain this copy for your office files.

Well No.

Wagner

G.D. Clark

es

2/2

Frank E West

#1 Warehouse  
180-146  
20-130  
0-20  
10  
20

board

part

20

Downer

4

140

29

141

144

2 in

2

1