

WAYNE
G 77
8-31-70

MISSISSIPPI
BOARD OF WATER COMMISSIONERS
416 North State Street
Jackson, Mississippi 39201

CODED

WATER WELL DRILLERS LOG

8-31 1970 HOMAND'S WELL SERV. WAYNE
date well completed firm name county well located

LANDOWNER: ELNOR DAVIS
ROUT 1,
SHUBUTA, MISS.
(mailing address)

description of formations encountered	from	to
<u>TOP SOIL</u>	<u>0</u>	<u>2</u>
<u>YELLOW CLAY</u>	<u>2</u>	<u>8</u>
<u>CORSE WHITE SAND</u>	<u>8</u>	<u>52</u>

WELL LOCATION:
sec. 30 T. 9 S. R. 8 E.
11 miles WEST of WAYNESBORO
(distance) (direction) (nearest town)

WELL PURPOSE: HOME
(home, irrigation, municipal, industrial)

- WELL COMPLETION DATA:
- (1) diameter (inches) 2"
 - (2) total depth (feet) 52'
 - (3) static water level (feet) 8 below / above top of ground.
 - (4) casing PLASTIC, 47'
(material) (depth)
2" If telescope see back.
(size)
 - (5) screen 5', 47'
(length) (depth to top)
2", PLASTIC
(size) (material)
 - (6) pump 1/2, 6
(HP) (yield gpm)
ELECT.
(type power)
 - (7) electric log NO
(yes or no)

CODED

(organization running log)
(8) how well bottom plugged B.W.U.


SEP 28 1970

DRILLERS REMARKS:

MISS. BD. OF
WATER COMMISSIONERS

If well telescopes please sketch and show depths.

GROUND LEVEL

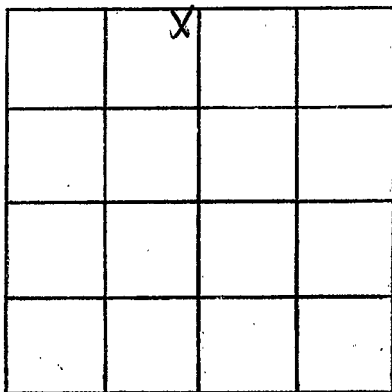

SECTION _____

Please indicate well location X.

ADDITIONAL INFORMATION

If more than one screen,
show locations of each on sketch.