

WAYNE
G 78
8-25-70

MISSISSIPPI
BOARD OF WATER COMMISSIONERS
416 North State Street
Jackson, Mississippi 39201

CODED

WATER WELL DRILLERS LOG

Aug 25 1970 Roy West Water Wells Wayne
date well completed firm name county well located

LANDOWNER: <u>John Newton Syles</u>	Description of formations encountered	from	to
<u>Shubuta Rt 1</u>	<u>Round clay</u>	<u>0</u>	<u>15</u>
	<u>Clay</u>	<u>15</u>	<u>30</u>
	<u>Sand</u>	<u>30</u>	<u>165</u>
	<u>Clay</u>	<u>165</u>	<u>180</u>
	<u>Sand</u>	<u>180</u>	<u>208</u>
	<u>Clay</u>	<u>208</u>	<u>215</u>
	<u>Blue Clay</u>	<u>215</u>	<u>350</u>
	<u>Blue Clay and rock</u>		
	<u>Clay</u>	<u>350</u>	<u>380</u>

(mailing address)
WELL LOCATION:
sec. 19 T. 9 N. R. 8 E.
2 0 miles west of Socorro
(distance) (direction) (nearest town)

WELL PURPOSE: home
(home, irrigation, municipal, industrial)

- WELL COMPLETION DATA:
- (1) diameter (inches) 2
 - (2) total depth (feet) 350
 - (3) static water level (feet) 130 below / above top of ground.
 - (4) casing galv 220
(material) (depth)
 - (size) if telescope see back.
 - (5) screen 0 0
(length) (depth to top)
 - (size) (material)
 - (6) pump 1 1/2 3
(HP) (yield gpm)
Rea
(type power)
 - (7) electric log NO
(yes or no)
 - (organization running log)
 - (8) how well bottom plugged washed

CODED


OCT 2 1970

DRILLERS REMARKS:

MISS. BD. OF
WATER COMMISSIONERS

If well telescopes please sketch and show depths.

GROUND LEVEL

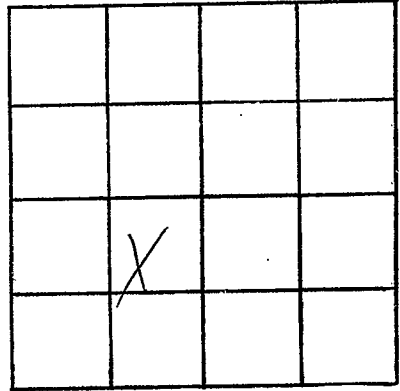

SECTION 19

Please indicate well location X.

ADDITIONAL INFORMATION

If more than one screen,
show locations of each on sketch.