

Wayne
G-79
7-9-70

MISSISSIPPI
BOARD OF WATER COMMISSIONERS
416 North State Street
Jackson, Mississippi 39201

CODED

WATER WELL DRILLERS LOG

July 9 1970 Royva start water wells Wayne
date well completed firm name county well located

LANDOWNER: Jim Williams
RT 1
Waynesboro Miss
(mailing address)

description of formations encountered	from	to
sondy clay	0	4
sand and gravel	4	100
Blue clay	100	120
Blue clay and	120	220
lime rock streaks (Vicksburg ls)		

WELL LOCATION:
sec. 23 T-9 N R-8 E
12 miles W of Waynesboro
(distance) (direction) (nearest town)

WELL PURPOSE: home
(home, irrigation, municipal, industrial)

WELL COMPLETION DATA:

(1) diameter (inches) 2 in
(2) total depth (feet) 240
(3) static water level (feet) 98 below top of ground.
(4) casing galv 210 (material) (depth)
(size) If telescope see back.
(5) screen none (length) (depth to top)
(size) (material)
(6) pump 1 1/2 (HP) 6 (yield gpm)
R6A (type power)
(7) electric log no (yes or no)
(organization running log)
(8) how well bottom plugged Open End


CODED

JUL 28 1970

DRILLERS REMARKS:

If well telescopes please sketch and show depths.

GROUND LEVEL

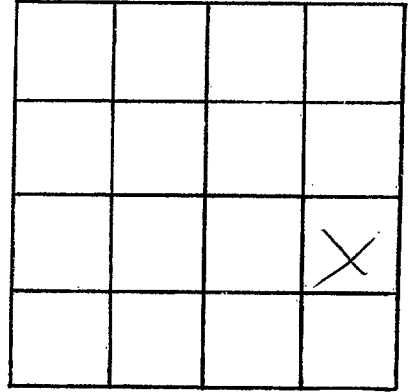

SECTION 23

Please indicate well location X.

ADDITIONAL INFORMATION

If more than one screen, show locations of each on sketch.