

Wayne
G 81
7-21-70

MISSISSIPPI
BOARD OF WATER COMMISSIONERS
416 North State Street
Jackson, Mississippi 39201
WATER WELL DRILLERS LOG

CODED

JULY 21 1970 HOWLAND'S WELL SERVICE WAYNE
date well completed firm name county well located

LANDOWNER: FRANCIS SELLERS
ROUT 1
WAYNESBORO, MISS.
(mailing address)
WELL LOCATION:
sec. 23 T 9 N R 8 E
7 miles N-W of WAYNESBORO
(distance) (direction) (nearest town)

description of formations encountered	from	to
TOP SOIL	0	2
RED CLAY	2	15
WHITE CHALK	15	18
WHITE WATER SAND	18	23

WELL PURPOSE: HOME
(home, irrigation, municipal, industrial)

WELL COMPLETION DATA:
(1) diameter (inches) 2"
(2) total depth (feet) 23'
(3) static water level (feet) 15' below top of ground.
(4) casing PLASTIC, 23' (material), (depth)
2" (size) if telescope see back.
(5) screen 5' (length), 18' (depth to top)
2" (size), PLASTIC (material)
(6) pump 5 (HP), 4 (yield gpm)
ELECTRIC (type power)
(7) electric log NO (yes or no)
(organization running log)
(8) how well bottom plugged BW-V

CODED


JUL 24 1970

DRILLERS REMARKS:

MISS. BD. OF WATER COMMISSIONERS

If well telescopes please sketch and show depths.

GROUND LEVEL

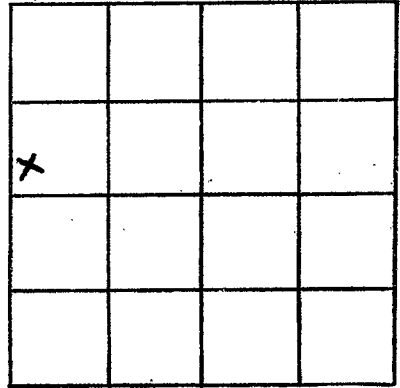

SECTION 23

Please indicate well location X.

ADDITIONAL INFORMATION

If more than one screen,
show locations of each on sketch.