

Wayne  
G 82  
8-10-70

MISSISSIPPI  
BOARD OF WATER COMMISSIONERS  
416 North State Street  
Jackson, Mississippi 39201  
WATER WELL DRILLERS LOG

**CODED**

Aug 10 1970 Holland's Water Well Ser. Wayne  
date well completed firm name county well located

LANDOWNER: Billy Cooley  
Rt. 1  
Shelburne Miss  
(mailing address)

description of formations encountered	from	to
RED CLAY	0	18
MED. RED SAND	18	30
PEA GRAVEL + SAND	30	35
COARSE WHITE SAND	35	48

WELL LOCATION:  
sec. 12 T. 9 N. R. 8 E  
S W  
miles of  
(distance) (direction) (nearest town)

WELL PURPOSE: HOME  
(home, irrigation, municipal, industrial)

WELL COMPLETION DATA:

(1) diameter (inches) 2"

(2) total depth (feet) 48'

(3) static water level (feet) 22' <sup>below</sup> above top of ground.

(4) casing PLASTIC, 43'  
(material) (depth)  
2" if telescope see back.  
(size)

(5) screen 5', 43'  
(length) (depth to top)  
2", PLASTIC  
(size) (material)

(6) pump 3/4, 5  
(HP) (yield gpm)  
ELECT.  
(type power)

(7) electric log NO  
(yes or no)

(organization running log)

(8) how well bottom plugged B-W-V.

**CODED**


AUG 21 1970

MISS. BD. OF  
WATER COMM.

DRILLERS REMARKS:

If well telescopes please sketch and show depths.

GROUND LEVEL

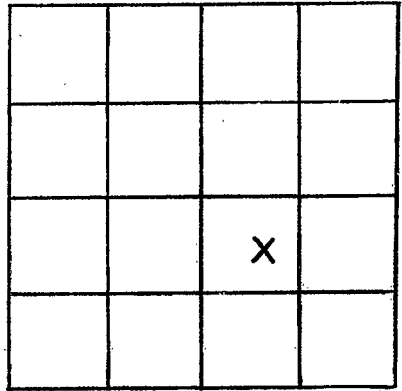

SECTION 12

Please indicate well location X.

ADDITIONAL INFORMATION

If more than one screen,  
show locations of each on sketch.