

MISSISSIPPI
BOARD OF WATER COMMISSIONERS
416 North State Street
Jackson, Mississippi 39201

CODED

WATER WELL DRILLERS LOG

WAYNE
G 83
11-13-70

Nov 23 1970 Porter Drilling Log Wayne
date well completed firm name county well located

LANDOWNER: E. J. V. Allen
211 Shubuta Miss
(mailing address)

description of formations encountered	from	to
<u>red clay & sand</u>	<u>0</u>	<u>40</u>
<u>sand & shells</u>	<u>40</u>	<u>70</u>
<u>sand</u>	<u>70</u>	<u>117</u>
<u>cherty</u>	<u>117</u>	<u>120</u>
<u>cherty</u>	<u>120</u>	<u>127</u>
<u>sand</u>	<u>127</u>	<u>133</u>

WELL LOCATION:
sec. 2 T 9 N R 8 E
8 miles NW of Waynesboro
(distance) (direction) (nearest town)

description of formations encountered	from	to
<u>red clay & sand</u>	<u>0</u>	<u>40</u>
<u>sand & shells</u>	<u>40</u>	<u>70</u>
<u>sand</u>	<u>70</u>	<u>117</u>
<u>cherty</u>	<u>117</u>	<u>120</u>
<u>cherty</u>	<u>120</u>	<u>127</u>
<u>sand</u>	<u>127</u>	<u>133</u>

WELL PURPOSE: none
(home, irrigation, municipal, industrial)

description of formations encountered	from	to
<u>red clay & sand</u>	<u>0</u>	<u>40</u>
<u>sand & shells</u>	<u>40</u>	<u>70</u>
<u>sand</u>	<u>70</u>	<u>117</u>
<u>cherty</u>	<u>117</u>	<u>120</u>
<u>cherty</u>	<u>120</u>	<u>127</u>
<u>sand</u>	<u>127</u>	<u>133</u>

WELL COMPLETION DATA:
(1) diameter (inches) 2 1/4
(2) total depth (feet) 133
(3) static water level (feet) 70 below top of ground.
(4) casing steel 127' (material) (depth)
2 (size) if telescope see back.
(5) screen 5' 130' (length) (depth to top)
1 1/2" galv S.S. (size) (material)
(6) pump 2 100 (HP) (yield gpm)
elec. (type power)
(7) electric log no (yes or no)
(organization running log)
(8) how well bottom plugged 1/2" galv S.S.

description of formations encountered	from	to
<u>red clay & sand</u>	<u>0</u>	<u>40</u>
<u>sand & shells</u>	<u>40</u>	<u>70</u>
<u>sand</u>	<u>70</u>	<u>117</u>
<u>cherty</u>	<u>117</u>	<u>120</u>
<u>cherty</u>	<u>120</u>	<u>127</u>
<u>sand</u>	<u>127</u>	<u>133</u>

CODED


NOV 16 1970

DRILLERS REMARKS:

MISS. BD. OF
WATER COMM.

If well telescopes please sketch and show depths.

GROUND LEVEL

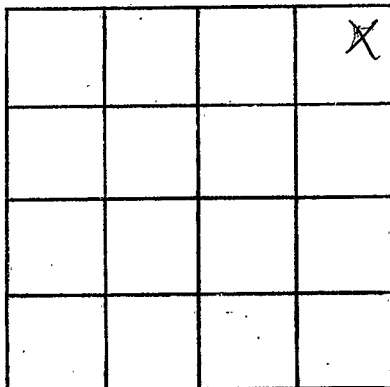

SECTION 2

Please indicate well location X.

ADDITIONAL INFORMATION

If more than one screen,
show locations of each on sketch.