

WAYNE  
G 84  
11-18-70

MISSISSIPPI  
BOARD OF WATER COMMISSIONERS  
416 North State Street  
Jackson, Mississippi 39201

**CODED**

WATER WELL DRILLERS LOG

Nov 18 1970 Barton Drilling & Supply Wayne  
date well completed firm name county well located

LANDOWNER: Marshall Mc Swain  
212 Hargraves Min.  
(mailing address)

WELL LOCATION:  
sec 2 T 20 N R 8 E  
S W  
10 miles NW of Waynesboro  
(distance) (direction) (nearest town)

WELL PURPOSE: None  
(home, irrigation, municipal, industrial)

WELL COMPLETION DATA:  
(1) diameter (inches) 2"  
(2) total depth (feet) 218'  
(3) static water level (feet) 143 (below/above top of ground)  
(4) casing steel 171'  
(material) (depth)  
2" if telescope see back.  
(size)  
(5) screen none used  
(length) (depth to top)  
(size) (material)  
(6) pump 2 6  
(HP) (yield gpm)  
elec  
(type power)  
(7) electric log no  
(yes or no)  
(organization running log)  
(8) how well bottom plugged none


description of formations encountered	from	to
rest clay	0	18
sand & chalk	18	25
chalk & sand	25	55
chalk	55	58
thin rock		58
blue chalk	58	105
over rock strata	105	137
blue chalk	137	190
Urbachery limestone	190	218

168' 1 1/4" dry pipe  
**CODED**  
DEC 21 1970  
MISS. Bd. OF WATER COMMISSIONERS

DRILLERS REMARKS:

If well telescopes please sketch and show depths.

GROUND LEVEL

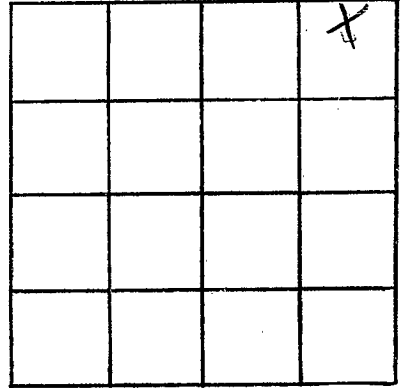

SECTION 2

Please indicate well location X.

ADDITIONAL INFORMATION

If more than one screen,  
show locations of each on sketch.