

WAYNE

G 85

12-16-70

MISSISSIPPI BOARD OF WATER COMMISSIONERS 416 North State Street Jackson, Mississippi 39201

CODED

WATER WELL DRILLERS LOG

Dec 16 1970 date well completed

P. H. Drilling Co. firm name

Wayne county well located

LANDOWNER: Carl & Josephine

description of formations encountered

from

to

Box 1 Magnolia Miss (mailing address)

red clay	0	15
red sand	15	17
white chalk	17	21
sand	31	44
sand & chalk	44	48
chalk	48	53
red sand	53	66
stratification chalk		

WELL LOCATION:

sec 34 T 9 N R 2 E S W of Magnolia (distance) (direction) (nearest town)

WELL PURPOSE: home (home, irrigation, municipal, industrial)

WELL COMPLETION DATA:

- (1) diameter (inches) 2"
- (2) total depth (feet) 66
- (3) static water level (feet) 36 below top of ground
- (4) casing steel 60' (material) (depth)
- (5) screen 6' 60' (length) (depth to top)
- (6) pump 1 (HP) 6 (yield gpm)
- (7) electric log no (yes or no)

6 1/4" 20 gpm ss with 2' 1/2" large pipe bent in with peacher 1/2" 1/4" large pipe

CODED


DEC 21 1970

MISS. BD. OF WATER COMMISSIONERS

DRILLERS REMARKS:

If well telescopes please sketch and show depths.

GROUND LEVEL

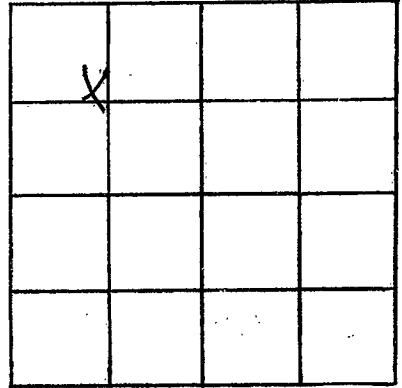

SECTION 34

Please indicate well location X.

ADDITIONAL INFORMATION

If more than one screen,
show locations of each on sketch.