

MISSISSIPPI
BOARD OF WATER COMMISSIONERS
416 North State Street
Jackson, Mississippi 39201

CODED

WATER WELL DRILLERS LOG

WAYNE
G86
1-13-71

Jan 13 1971 H. Roy Winst Waterwells Wayne
date well completed firm name county well located

LANDOWNER: Walter Gattlin
Waynesboro Miss
R 1
(mailing address)

WELL LOCATION:
sec 32 T 9 N R 8 E
12 miles S E of Waynesboro
(distance) (direction) (nearest town)

WELL PURPOSE: home
(home, irrigation, municipal, industrial)

- WELL COMPLETION DATA:
- (1) diameter (inches) 2
 - (2) total depth (feet) 410
 - (3) static water level (feet) 128 below top of ground.
 - (4) casing galv 32.6 (material) (depth)
 - (size) if telescope see back.
 - (5) screen none (length) (depth to top)
 - (size) (material)
 - (6) pump 1 1/2 5 (HP) (yield gpm)
 - Rea (type power)
 - (7) electric log no (yes or no)
 - (organization running log)
 - (8) how well bottom plugged

description of formations encountered	from	to
Clay	0	6
Sandy Clay	6	35
Clay	35	70
sand	70	220
Blue Clay	220	340
struck rock and clay	340	370
Blue Clay	370	410

CODED


JAN 25 1971

MISS. BD. OF
WATER COMM.

DRILLERS REMARKS:

If well telescopes please sketch and show depths.

GROUND LEVEL

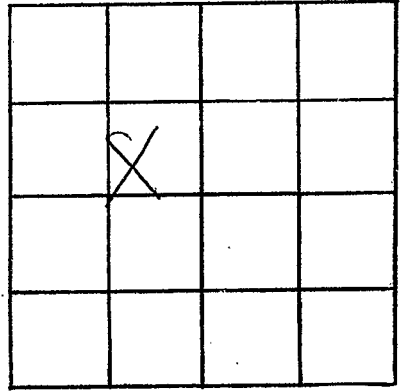

SECTION 32

Please indicate well location X.

ADDITIONAL INFORMATION

If more than one screen,
show locations of each on sketch.