

WAYNE

MISSISSIPPI BOARD OF WATER COMMISSIONERS

OG87

CODED

5-25-62

WATER WELL DRILLERS LOG

Date: 5/25, 1962, Driller: C.P. Clark County Jones
453/19 (Name)

(1) Owner of Land: J.H. Finley
 (Name)
 Rt #3 Shubutla Miss
 (Address)

(2) Location: 1/4, 1/4, Sec. 7 T. 9 R. 8
 10 miles S.E. of Shubutla
 (distance) (direction) (Nearest Town)

(3) Topography: (Hilly) (Flat) (Level)

(4) Purpose of Well: Domestic Irrigation
 Municipal, Industrial, Other

Description & Color of Materials Sand, Clay, Red Clay, Shell, etc.	Thick- ness Feet	Depth Feet
0-30 Clay	30	
30-42 Sand	12	
42-120 Blue Clay	78	
120-140 Blue Sand	20	

Information upon completion of well:

(1) Diameter 2 inches.

(2) Total Depth 140 feet.

(3) Water Level 102 feet below top of ground.

(4) Cased to 135, Size 2

(5) Screen: Size 1 1/4, Length 5


(6) Were any formations sealed against pollution?
 _____ yes, no.

If YES depth of formation _____

Why _____

Drillers Remarks: _____

CODED

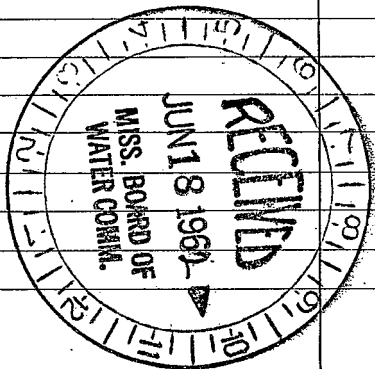

(Use Back Side)

Well No.

