

WAYNE
G 88
5-19-71

MISSISSIPPI
BOARD OF WATER COMMISSIONERS
416 North State Street
Jackson, Mississippi 39201

CODED

WATER WELL DRILLERS LOG

May 19 1971 Roy West water wells Wayne
date well completed firm name county well located

LANDOWNER: John S Jones
Rt 1
Shubetta Miss
(mailing address)

description of formations encountered	from	to
Sandy clay	0	16
Clay	16	28
Sandy clay	28	38
Clay	38	96
Sand	96	123

WELL LOCATION:
sec. 31 T. 9 N. R. 8 E
11 miles W of Waynesboro
(distance) (direction) (nearest town)

WELL PURPOSE: home
(home, irrigation, municipal, industrial)

- WELL COMPLETION DATA:
- (1) diameter (inches) 2 in
 - (2) total depth (feet) 123
 - (3) static water level (feet) 48 below top of ground.
 - (4) casing Galv (material) 118 (depth)
 - (size) If telescope see back.
 - (5) screen 5 (length) 118 (depth to top)
 - 1 1/4 (size) St Steel (material)
 - (6) pump 1 (HP) 12 (yield gpm)
 - Rea (type power)
 - (7) electric log No (yes or no)

CODED


(organization running log)
(8) how well bottom plugged wash water

DRILLERS REMARKS:

MAY 6 1971
MISS. Bd. of WATER COM.

If well telescopes please sketch and show depths.

GROUND LEVEL

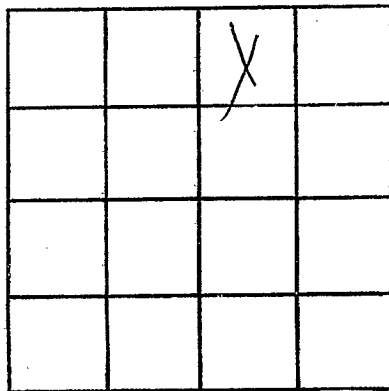

SECTION 31

Please indicate well location X.

ADDITIONAL INFORMATION

If more than one screen, show locations of each on sketch.