

MISSISSIPPI
BOARD OF WATER COMMISSIONERS
416 North State Street
Jackson, Mississippi 39201

CODED

WATER WELL DRILLERS LOG

WAYNE
G 89
6-15-71

June 15 1971 Roy V Westwater Wells Wayne
date well completed firm name county well located

LANDOWNER:	Description of formations encountered	from	to
<u>Sylvester West</u> <u>Rt 2 Waynesboro</u>	<u>Clay</u> <u>sandy clay</u> <u>Round</u>	<u>0</u> <u>6</u> <u>25</u>	<u>6</u> <u>25</u> <u>104</u>
(mailing address)			

WELL LOCATION:
sec 34 T 9 N R 8 E
16 miles W of Waynesboro
(distance) (direction) (nearest town)

WELL PURPOSE: home
(home, irrigation, municipal, industrial)

- WELL COMPLETION DATA:
- (1) diameter (inches) 2 in
 - (2) total depth (feet) 104
 - (3) static water level (feet) 80 below above top of ground.
 - (4) casing plastic 98
(material) (depth)
(size) if telescope see back.
 - (5) screen 5 ft 98
(length) (depth to top)
1/4 st steel
(size) (material)
 - (6) pump 2 10
(HP) (yield gpm)
Rea
(type power)
 - (7) electric log NO
(yes or no)
 - (organization running log)
 - (8) how well bottom plugged wash holes

CODED


JUL 6 1971

MISS. BD. OF
WATER COMMISSIONERS

DRILLERS REMARKS:

If well telescopes please sketch and show depths.

GROUND LEVEL

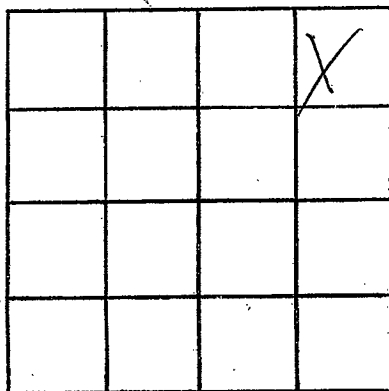

SECTION 34

Please indicate well location X.

ADDITIONAL INFORMATION

If more than one screen,
show locations of each on sketch.