

WAYNE

G 91

6-22-71

MISSISSIPPI BOARD OF WATER COMMISSIONERS
416 North State Street
Jackson, Mississippi 39201

CODED

WATER WELL DRILLERS LOG

June 22 1971 Porter Drilling Co. Wayne
date well completed firm name county well located

LANDOWNER: Carol Bonner

description of formations encountered	from	to
red chalk	0	12
sand	12	40
sand & chalk	40	79
chalk	79	139
sand	139	180
blue chalk	180	228
rock strata	228	261
blue chalk	261	301
Vicksburg	301	330

At 1 Shubuta Miss
(mailing address)

WELL LOCATION:

sec. 30 T. 9 N. R. 8 E. W
10 miles W of Waynesboro
(distance) (direction) (nearest town)

WELL PURPOSE: home
(home, irrigation, municipal, industrial)

WELL COMPLETION DATA:

- (1) diameter (inches) 4"
- (2) total depth (feet) 330'
- (3) static water level (feet) 120 (below/above top of ground)
- (4) casing steel 304'
(material) (depth)
4" if telescope see back.
(size)
- (5) screen none used
(length) (depth to top)
(size) (material)
- (6) pump 2 rod 3 1/2
(HP) (yield gpm)
elec.
(type power)
- (7) electric log no
(yes or no)
(organization running log)
- (8) how well bottom plugged yes

147' 2" long pipe
will ent. set in bottom

CODED


JUL 14 1971

DRILLERS REMARKS:

MISS. Bd. of
WATER COMM.

If well telescopes please sketch and show depths.

GROUND LEVEL

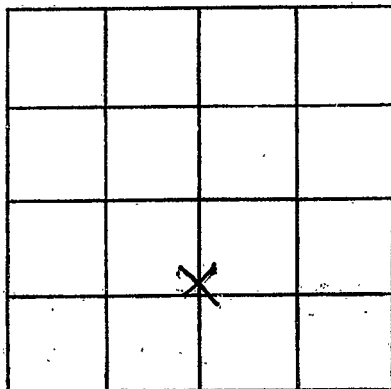

SECTION 30

Please indicate well location X.

ADDITIONAL INFORMATION

If more than one screen, show locations of each on sketch.