

Wayne
G-92
8-9-71

MISSISSIPPI
BOARD OF WATER COMMISSIONERS
416 North State Street
Jackson, Mississippi 39201

CODED

WATER WELL DRILLERS LOG

CODED

AUG. 9 1971 HOWARD'S WELL SERV. WAYNE

date well completed

firm name

county well located

LANDOWNER: CHARLIE WEST

description of formations encountered

from to

SHERBUTA, MISS.
(mailing address)

TOP SOIL	0	1
RED CLAY	1	8
SAND ROCK	8	9
RED SAND	9	4.5
MED. COARSE SAND	4.5	6.2
SAND ROCK	6.2	6.3
MED. WATER SAND	6.3	6.8

WELL LOCATION:

sec. 3 T. 9 N. R. 8 E

15 miles N of WAYNESBURG
(distance) (direction) (nearest town)

WELL PURPOSE: HOME
(home, irrigation, municipal, industrial)

WELL COMPLETION DATA:

- (1) diameter (inches) 2"
- (2) total depth (feet) 68'
- (3) static water level (feet) 55' ^{below} above top of ground.
- (4) casing PVC, 62'
(material) (depth)
2" if telescope see back.
(size)
- (5) screen 6' 62'
(length) (depth to top)
1 1/2" PVC.
(size) (material)
- (6) pump 1/2 3
(HP) (yield gpm)
- ELECT.
(type power)
- (7) electric log NO
(yes or no)

(organization running log)

(8) how well bottom plugged PVC.


SEP 9 1971

DRILLERS REMARKS:

MISSISSIPPI BOARD OF WATER COMMISSIONERS
STATE PRINTING

If well telescopes please sketch and show depths.

GROUND LEVEL

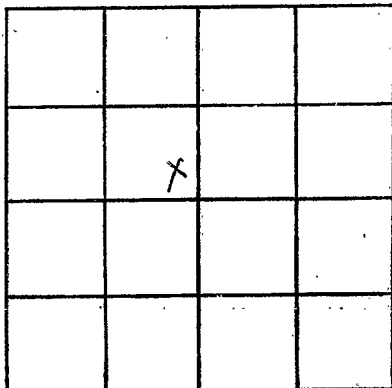

SECTION 3

Please indicate well location X.

ADDITIONAL INFORMATION

If more than one screen,
show locations of each on sketch.