

WAYNE

G 93

9-8-71

MISSISSIPPI
 BOARD OF WATER COMMISSIONERS
 416 North State Street
 Jackson, Mississippi 39201

WATER WELL DRILLERS LOG

date well completed 1971 firm name **COILED** company well located

LANDOWNER: Thomas Davis

description of formations encountered

from to

Box 1 Hargreaves Miss
 (mailing address)

sand & chalk 0 20
 concrete and gravel 20 26
 sand & shale
 fill in sand

WELL LOCATION:

sec 35 T 90 N R 8 E
 S W
 7 miles west Hargreaves
 (distance) (direction) of (nearest town)

WELL PURPOSE: home
 (home, irrigation, municipal, industrial)

WELL COMPLETION DATA:

- (1) diameter (inches) 2"
- (2) total depth (feet) 76'
- (3) static water level (feet) 55' below above top of ground.
- (4) casing steel 70' (material) (depth)
 2' if telescope see back. (size)
- (5) screen 2" 73 (length) (depth to top)
 1 1/2" galv 3.5. (size) (material)
- (6) pump 1 (HP) 75 (yield gpm)
 elec (type power)
- (7) electric log (yes or no)
- (organization running log)

3' 1/2" galv 55' sand
 1 1/2" galv 3.5' in
 with packer
 1 1/2" galv 3.5' pipe




OCT 6 1971

DRILLERS REMARKS:

MISS. Bd. OF WATER COMM.

If well telescopes please sketch and show depths.

GROUND LEVEL

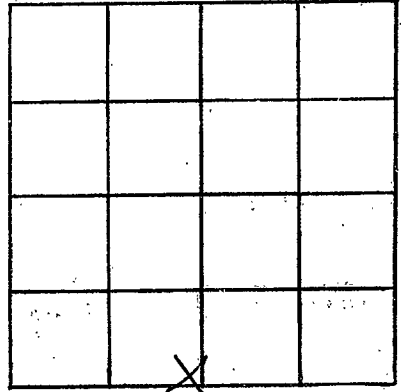

SECTION 35

Please indicate well location X.

ADDITIONAL INFORMATION

If more than one screen, show locations of each on sketch.