

Wayne
G 95
11-10-79

MISSISSIPPI
BOARD OF WATER COMMISSIONERS
416 North State Street
Jackson, Mississippi 39201

CODED

WATER WELL DRILLERS LOG

Nov 10 1979 Roy West Waterwells Wayne
date well completed firm name county well located

LANDOWNER: Lois Huddleston
Rt 1
Shubetta Miss
(mailing address)

description of formations encountered	from	to
clay	0	15
sand	15	45
blue clay	45	68
sand	68	75

WELL LOCATION:
sec. 6 T 9 N R 8 E
12 miles S of Shubetta
(distance) (direction) (nearest town)

WELL PURPOSE: home
(home, irrigation, municipal, industrial)


- WELL COMPLETION DATA:
- (1) diameter (inches) 2
 - (2) total depth (feet) 75
 - (3) static water level (feet) 35 below top of ground.
 - (4) casing galv 70 (material) (depth)
 - (size) if telescope see back.
 - (5) screen 5ft 70 (length) (depth to top)
 - 1 1/2 St Steel (size) (material)
 - (6) pump 1/2 5 (HP) (yield gpm)
 - Rea (type power)
 - (7) electric log 710 (yes or no)
 - (organization running log)
 - (8) how well bottom plugged wash water

CODED

DRILLERS REMARKS:

If well telescopes please sketch and show depths.

GROUND LEVEL

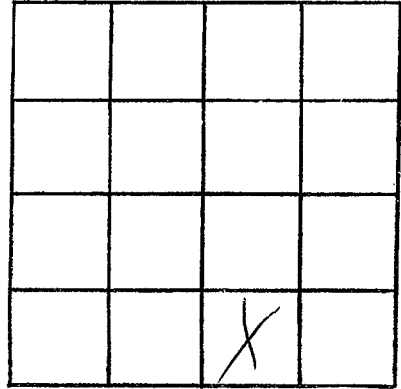

SECTION 6

Please indicate well location X.

ADDITIONAL INFORMATION

If more than one screen,
show locations of each on sketch.