

Wayne  
G 96  
2-14-72

T.M.C.A.

MISSISSIPPI  
BOARD OF WATER COMMISSIONERS  
416 North State Street  
Jackson Mississippi 39201

MAR 17 1972

CODED

WATER WELL DRILLERS LOG

Feb 14 1972 Roy West Water Well Drilling Co. Wayne  
date well completed firm name county well located

LANDOWNER: Carley J. Smith  
Rt 1 Sheubuta Miss  
(mailing address)

description of formations encountered	from	to
	clay	0
sand	8	70

WELL LOCATION:  
sec 30 T 9 N R 8 E  
1/4 miles E of Laurel  
(distance) (direction) (nearest town)

WELL PURPOSE: home  
(home, irrigation, municipal, industrial)


- WELL COMPLETION DATA:
- (1) diameter (inches) 2
  - (2) total depth (feet) 70
  - (3) static water level (feet) 25 below top of ground.
  - (4) casing galv 6.5 (material) (depth)
  - (size) if telescope see back.
  - (5) screen 5 6.5 (length) (depth to top)
  - 1/4 steel (size) (material)
  - (6) pump 1/4 7 (HP) (yield gpm)
  - RLA (type power)
  - (7) electric log NO (yes or no)
  - (organization running log)
  - (8) how well bottom plugged wash valve

CODED

DRILLERS REMARKS:

If well telescopes please sketch and show depths.

GROUND LEVEL

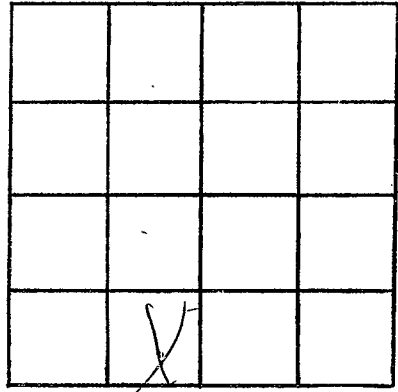

SECTION 38

Please indicate well location X.

ADDITIONAL INFORMATION

If more than one screen,  
show locations of each on sketch.