

Wayne  
G97  
4-18-72

MISSISSIPPI  
BOARD OF WATER COMMISSIONERS  
416 North State Street  
Jackson, Mississippi 39201

WATER WELL DRILLERS LOG

**CODED**

April 18 1972 Roy W. St. Waterwells Wayne  
date well completed firm name county well located

LANDOWNER: W. H. Dwyer  
Rt 1 Sharbutas  
(mailing address)

| description of formations encountered | from | to  |
|---------------------------------------|------|-----|
| Sandy clay                            | 0    | 10  |
| Clay                                  | 10   | 40  |
| Sandy clay                            | 40   | 75  |
| Clay                                  | 75   | 140 |
| Gravel                                | 140  | 166 |

WELL LOCATION:  
sec. 11 T. 9 N R. 8 E  
12 miles W of Waynesboro  
(distance) (direction) (nearest town)

WELL PURPOSE: home  
(home, irrigation, municipal, industrial)

- WELL COMPLETION DATA:
- (1) diameter (inches) 2
  - (2) total depth (feet) 166
  - (3) static water level (feet) 88 below/above top of ground.
  - (4) casing galv. 160 (material) (depth)
  - (size) if telescope see back.
  - (5) screen 5ft 160 (length) (depth to top)
  - 1/4" 8" (size) (material)
  - (6) pump 1 (HP) 8 (yield gpm)
  - REA (type power)
  - (7) electric log 710 (yes or no)
  - (organization running log)
  - (8) how well bottom plugged washed

**CODED**


MAY 2 - 1972

MISS. BD. OF  
WATER COMMISSIONERS

DRILLERS REMARKS:

If well telescopes please sketch and show depths.

GROUND LEVEL

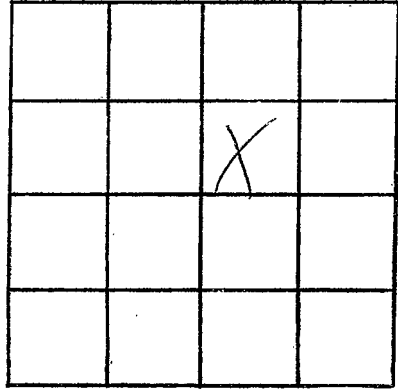

SECTION 11

Please indicate well location X.

ADDITIONAL INFORMATION

If more than one screen,  
show locations of each on sketch.