

WAYNE
G99
4-11-72

MISSISSIPPI
BOARD OF WATER COMMISSIONERS
416 North State Street
Jackson, Mississippi 39201

CODED

WATER WELL DRILLERS LOG

April 11 1972 Porter Drilling & Log Wayne
date well completed firm name county well located

LANDOWNER: <u>Franklin Davis</u>	description of formations encountered	from	to
<u>At 1 Shubuta Mine</u> (mailing address)	<u>Coarse sand</u> <u>Chalk & sand</u> <u>middle sand</u> <u>stratified Chalky sand</u>	<u>0</u> <u>22</u> <u>54</u>	<u>22</u> <u>54</u> <u>85</u>
WELL LOCATION: sec. <u>3</u> T. <u>9</u> N. R. <u>8</u> S. <u>11</u> miles <u>NW</u> of <u>Waynesboro</u> (distance) (direction) (nearest town)			
WELL PURPOSE: <u>home</u> (home, irrigation, municipal, industrial)			
WELL COMPLETION DATA:			
(1) diameter (inches) <u>2"</u>			
(2) total depth (feet) <u>25'</u>			
(3) static water level (feet) <u>59'</u> below top of ground.			
(4) casing <u>steel</u> <u>79 1/2'</u> (material) (depth)			
<u>2'</u> if telescope see back. (size)			
(5) screen <u>5'</u> <u>20'</u> (length) (depth to top)			
<u>1 1/4"</u> <u>6 slot S.S.</u> (size) (material)			
(6) pump <u>3U</u> <u>5'</u> (HP) (yield gpm)			
<u>elec.</u> (type power)			
(7) electric log <u>no</u> (yes or no)			
(organization running log)			
(8) how well bottom plugged <u>flashed cement</u>			
DRILLERS REMARKS:			


CODED

MAY 12 1972

MISS. BD. OF
WATER COMMISSIONERS

If well telescopes please sketch and show depths.

GROUND LEVEL

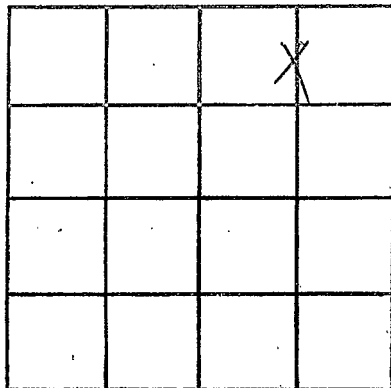

SECTION 3

Please indicate well location X.

ADDITIONAL INFORMATION

If more than one screen,
show locations of each on sketch.