

Wayne  
G 100  
6-28-72

MISSISSIPPI  
BOARD OF WATER COMMISSIONERS  
416 North State Street  
Jackson, Mississippi 39201

WATER WELL DRILLERS LOG  
CLANTON & McILWAIN

JUNE 28 1972 WATER WELL SER. WAYNE  
date well completed firm name county well located

LANDOWNER:  
LOWERY ASSEMBLY OF  
GOD CHURCH  
ROUTE 1 WAYNESBORO, MISS.  
(mailing address)

description of formations encountered	from	to
Sand + Gravel	0	10
Clay	10	25
Sand + Gravel	25	105

WELL LOCATION:  
sec. 23 T 9 N R 8 E  
9 miles NW of WAYNESBORO  
(distance) (direction) (nearest town)

WELL PURPOSE: FOR CHURCH  
(home, irrigation, municipal, industrial)


- WELL COMPLETION DATA:
- (1) diameter (inches) 2"
  - (2) total depth (feet) 105
  - (3) static water level (feet) 54' below top of ground.
  - (4) casing PVC 99' (material) (depth)  
2" (size) If telescope see back.
  - (5) screen 6' 98 1/2' (length) (depth to top)  
1 1/4" PVC (size) (material)
  - (6) pump 1/2 HP 6.5 (yield gpm)  
110 AC (type power)
  - (7) electric log NO (yes or no)
- (organization running log)
- (8) how well bottom plugged

JUL 12 1972

DRILLERS REMARKS:

If well telescopes please sketch and show depths.

GROUND LEVEL

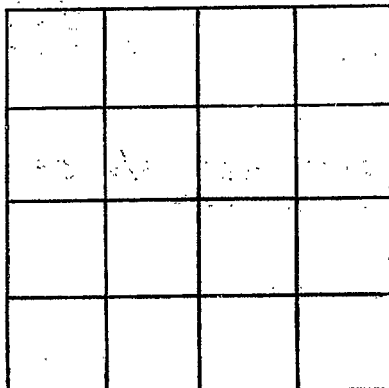

SECTION \_\_\_\_\_

Please indicate well location X.

ADDITIONAL INFORMATION

If more than one screen, show locations of each on sketch.