

Wayne
G 102
9-5-72

MISSISSIPPI
BOARD OF WATER COMMISSIONERS
416 North State Street
Jackson, Mississippi 39201

WATER WELL DRILLERS LOG

CODED

CLANTON + M^{rs} ILWAIN
WATER WELL SER.

WAYNE

SEPT 5, 1972
date well completed

firm name

county well located

LANDOWNER:	description of formations encountered	from	to
J. B. WALLER			
Rt 1, SHUBUTTA, Miss. (mailing address)	Sand	20	28
WELL LOCATION:	Sand + clay	28	50
sec. 4 T. 9 N R. 8 W	Sand	50	65
10 miles NW of WILBORO (distance) (direction) (nearest town)			
WELL PURPOSE: HOME (home, irrigation, municipal, industrial)			
WELL COMPLETION DATA:			
(1) diameter (inches) 2"			
(2) total depth (feet) 65'			
(3) static water level (feet) 46' below top of ground.			
(4) casing PVC 60' (material) (depth)			
2" (size) if telescope see back.			
(5) screen 5' 60' (length) (depth to top)			
2" PVC .008 (size) (material)			
(6) pump 1/2 5 (HP) (yield gpm)			
110 AC (type power)			
(7) electric log NO (yes or no)			
(organization running log)			
(8) how well bottom plugged			
DRILLERS REMARKS:			


CODED

SEP 13 1972

MISS. RD. 49
STATE BOWL

If well telescopes please sketch and show depths.

GROUND LEVEL

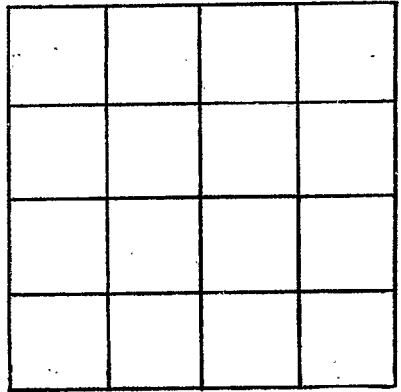

SECTION _____

Please indicate well location X.

ADDITIONAL INFORMATION

If more than one screen, show locations of each on sketch.