

Wayne
G 104
8-21-72

MISSISSIPPI
BOARD OF WATER COMMISSIONERS
416 North State Street
Jackson, Mississippi 39201
WATER WELL DRILLERS LOG

CODED

8-21-72 date well completed 72 Mc Donald & Hill, Inc firm name Wayne county well located

LANDOWNER: Crystal Conley
pt # 1

Shubuta miss
(mailing address)

WELL LOCATION:
sec. 20 T 9 N R 8 E
14 miles west of Shubuta
(distance) (direction) (nearest town)

WELL PURPOSE: home
(home, irrigation, municipal, industrial)

WELL COMPLETION DATA:

- (1) diameter (inches) 2
- (2) total depth (feet) 110
- (3) static water level (feet) 52 below above top of ground.
- (4) casing 2 Plyt Ren 105
(material) (depth)
no if telescope see back.
(size)
- (5) screen 5 105
(length) (depth to top)
2" Plastic
(size) (material)
- (6) pump 3/4 10
(HP) (yield gpm)
jet
(type, power)
- (7) electric log no
(yes or no)
- (organization running log)
- (8) how well bottom plugged
wash pressure valve

description of formations encountered	from	to
Clay	0	40
Coarse sand	40	60
Clay	60	75
st. clay & sand	75	100
Coarse sand	100	110

CODED

10/12
X


AUG 23 1972

DRILLERS REMARKS: none

MISS. BD. OF
WATER COMMISSIONERS

If well telescopes please sketch and show depths.

GROUND LEVEL

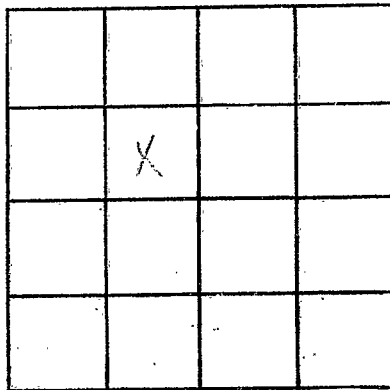

SECTION 20

Please indicate well location X.

ADDITIONAL INFORMATION

If more than one screen, show locations of each on sketch.